


P:\RecordDrawings\C399312\SWT01_P.dwg rainwab 09/21/00 09:27 AM

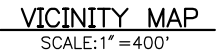

ABBREVIATIONS

TSE: TOP SWALE ELEVATION
BSE: BOTTOM SWALE ELEVATION
ORF DIAM: ORIFICE DIAMETER
* PERF: PREFERRED


FLOW MONITORING POOL CONSTRUCTION SHALL BE FIRST ORDER OF WORK AND SHALL BE CONSTRUCTED AND OPERATED TO CHANNEL ALL SURFACE DRAINAGE THROUGH AND DURING CONSTRUCTION. THIS SHALL BE OPERATED AS A SEDIMENT CONTAINMENT AREA SO THAT NO SEDIMENT ENTERS THE DOWN STREAM DRAINAGE SYSTEM OR PIPERS CREEK AND IT'S TRIBUTARIES (SEE SHEET 3).

RECORD DRAWING

S.E.A. STREET
2nd AVE NW
(NW 117TH TO NW 120TH)


JOB NO.	PC	C399312
	R/W	
	CO	C399312
VAULT PLAN NO. 777-162		
SHEET 1 OF 14		

P:\RecordDrawings\C399312\SWT03_P.dwg rainwab 09/21/00 09:31 AM

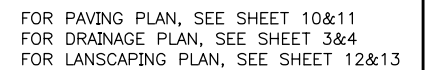


S.E.A. STREET
2nd AVE NW
(NW 117TH TO NW 120TH)

JOB NO.	PC	C399312
	R/W	
	CO	C399312
VAULT PLAN NO. 777-162		
SHEET 4 OF 14		


City of Seattle
Seattle Public Utilities
Diana Gale, Director
 ORDINANCE NO. _____ APPROVED _____
 FUND: _____
 SCALE: H 1"=20' V 1"=10' INSPECTOR'S BOOK _____


P	dwg	mtime	09/21/00	09:13 AM
P:\RecordDrawings\CI99112\SWT04				

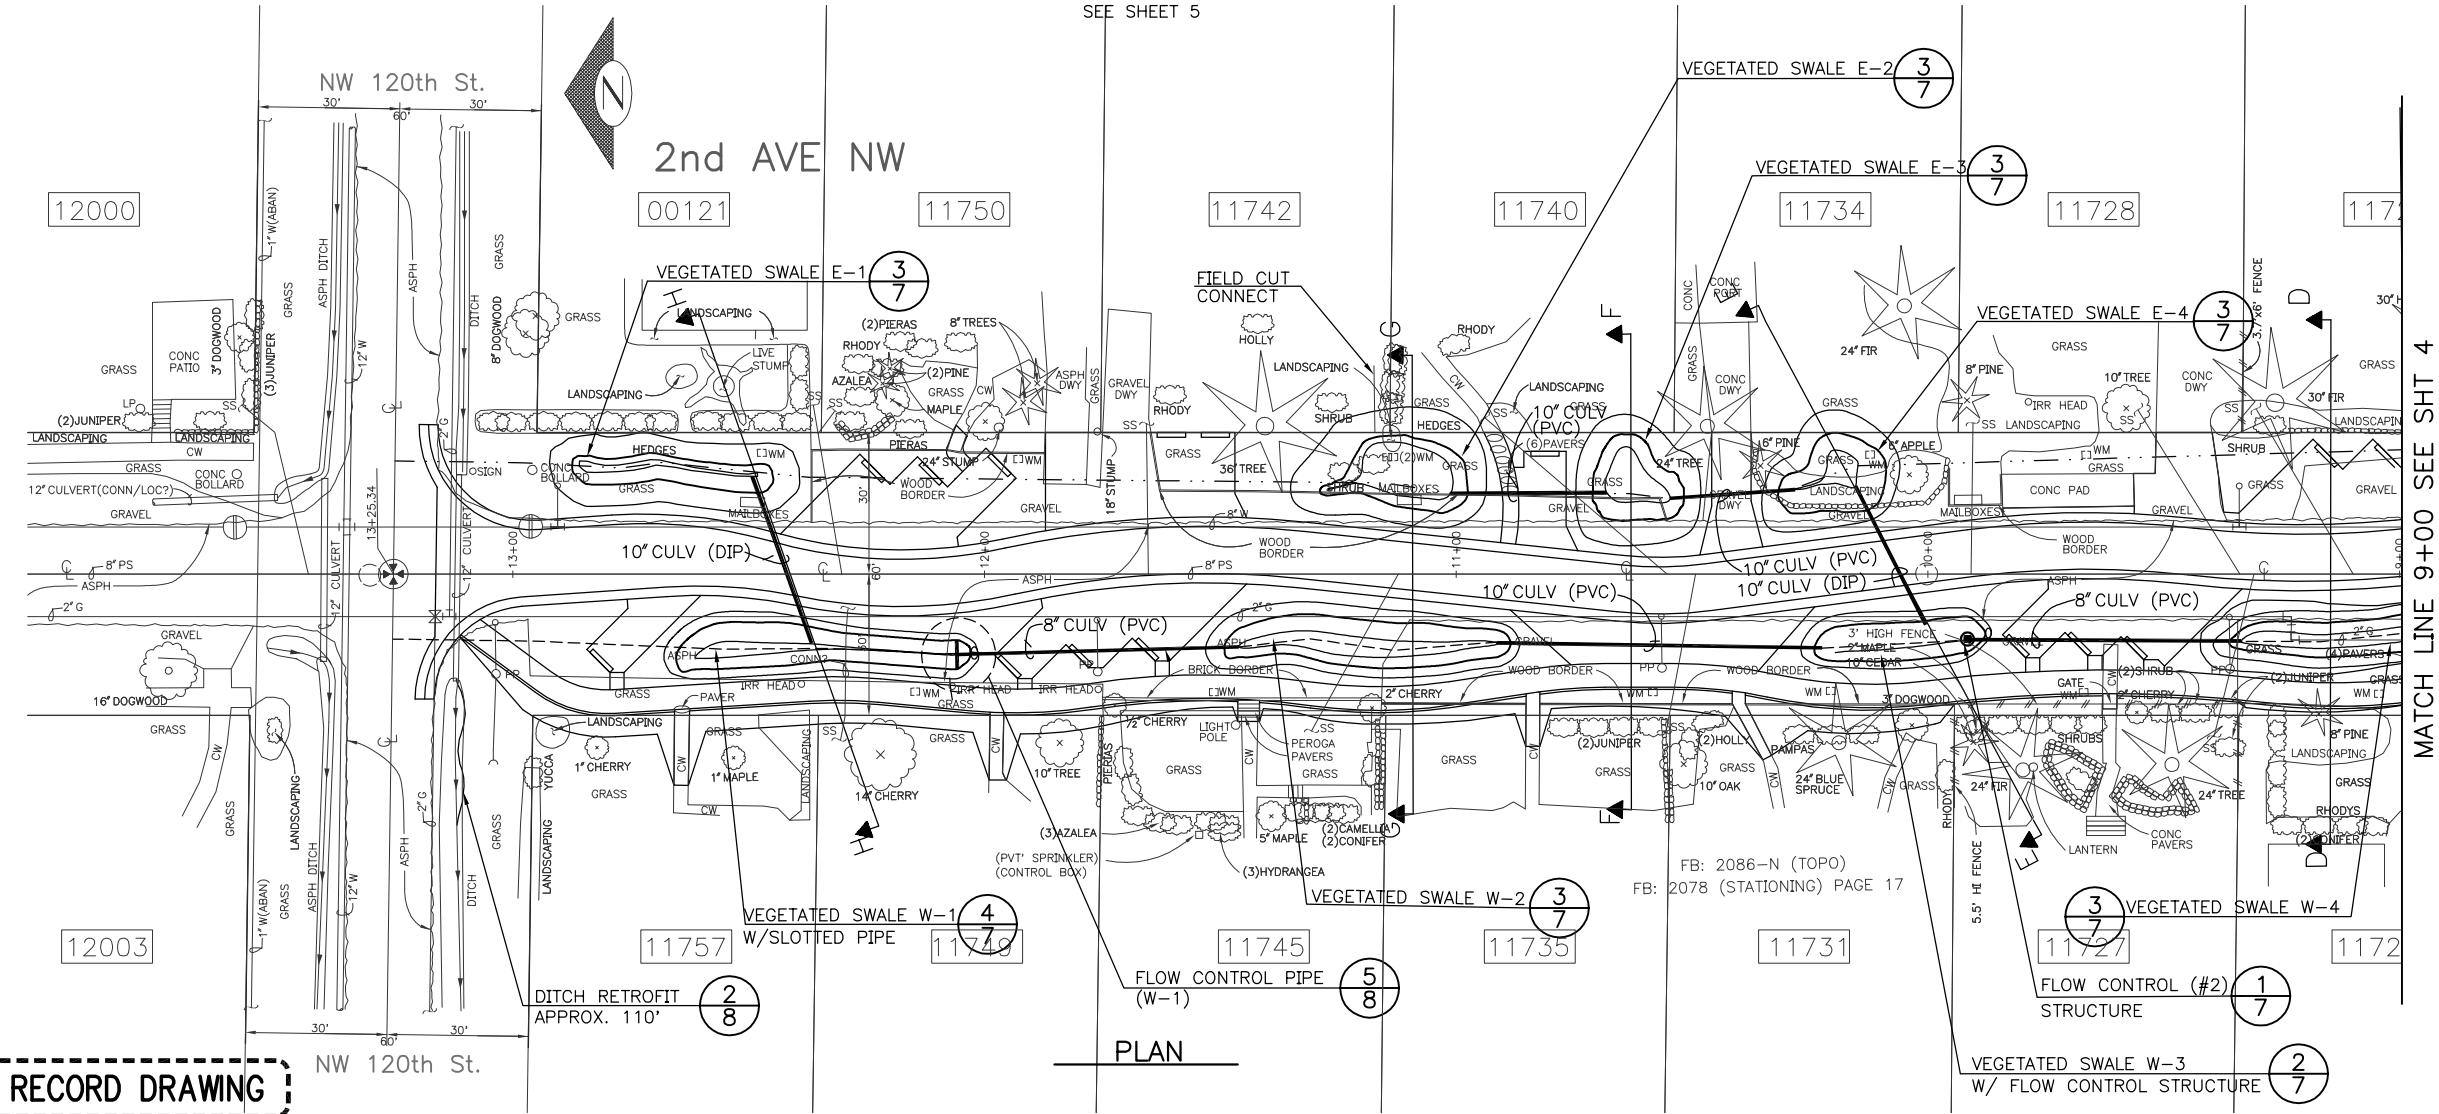

— · — · — EAST SIDE DRAINAGE CENTERLINE
 - - - - - WEST SIDE DRAINAGE CENTERLINE



FOR PAVING PLAN, SEE SHEET 10&11
FOR DRAINAGE PLAN, SEE SHEET 3&4
FOR LANDSCAPING PLAN, SEE SHEET 12&13

DRAINAGE PLAN & PROFILE


APPROVED FOR ADVERTISING DWIGHT DYER EXECUTIVE SERVICES DIRECTOR SEATTLE, WASHINGTON 20		NAME OR INITIALS AND DATE DESIGNED CHECKED	INITIALS AND DATE REVIEWED: DES. CONST. SEATLAN PROJ. MGR.	 City of Seattle <i>Seattle Public Utilities</i> Diana Gale, Director ORDINANCE NO. APPROVED FUND: SCALE: H 1"=20' V 1"=10' INSPECTOR'S BOOK	S.E.A. STREET 2nd AVE NW (NW 117TH TO NW 120TH)	JOB NO. PC C399312		
BY: CONTRACTING MANAGER		DRAWN CHECKED	RECEIVED REVISED AS BUILT			R/W CO C399312		
ALL WORK DONE IN ACCORDANCE WITH THE CITY OF SEATTLE STANDARD PLANS AND SPECIFICATIONS AND OTHER DOCUMENTS CALLED FOR IN SECTION 0-02.3 OF THE PROJECT MANUAL.						VAULT PLAN NO. 777-162		
						SHEET 3 OF 14		

VAULT	SERIAL NO.	DATE	MARK	NATURE	MADE	CHK'D	REV'D
	33655						

P:\RecordDrawings\C399312\SWT02__P.dwg rainwab 09/21/00 09:29 AM

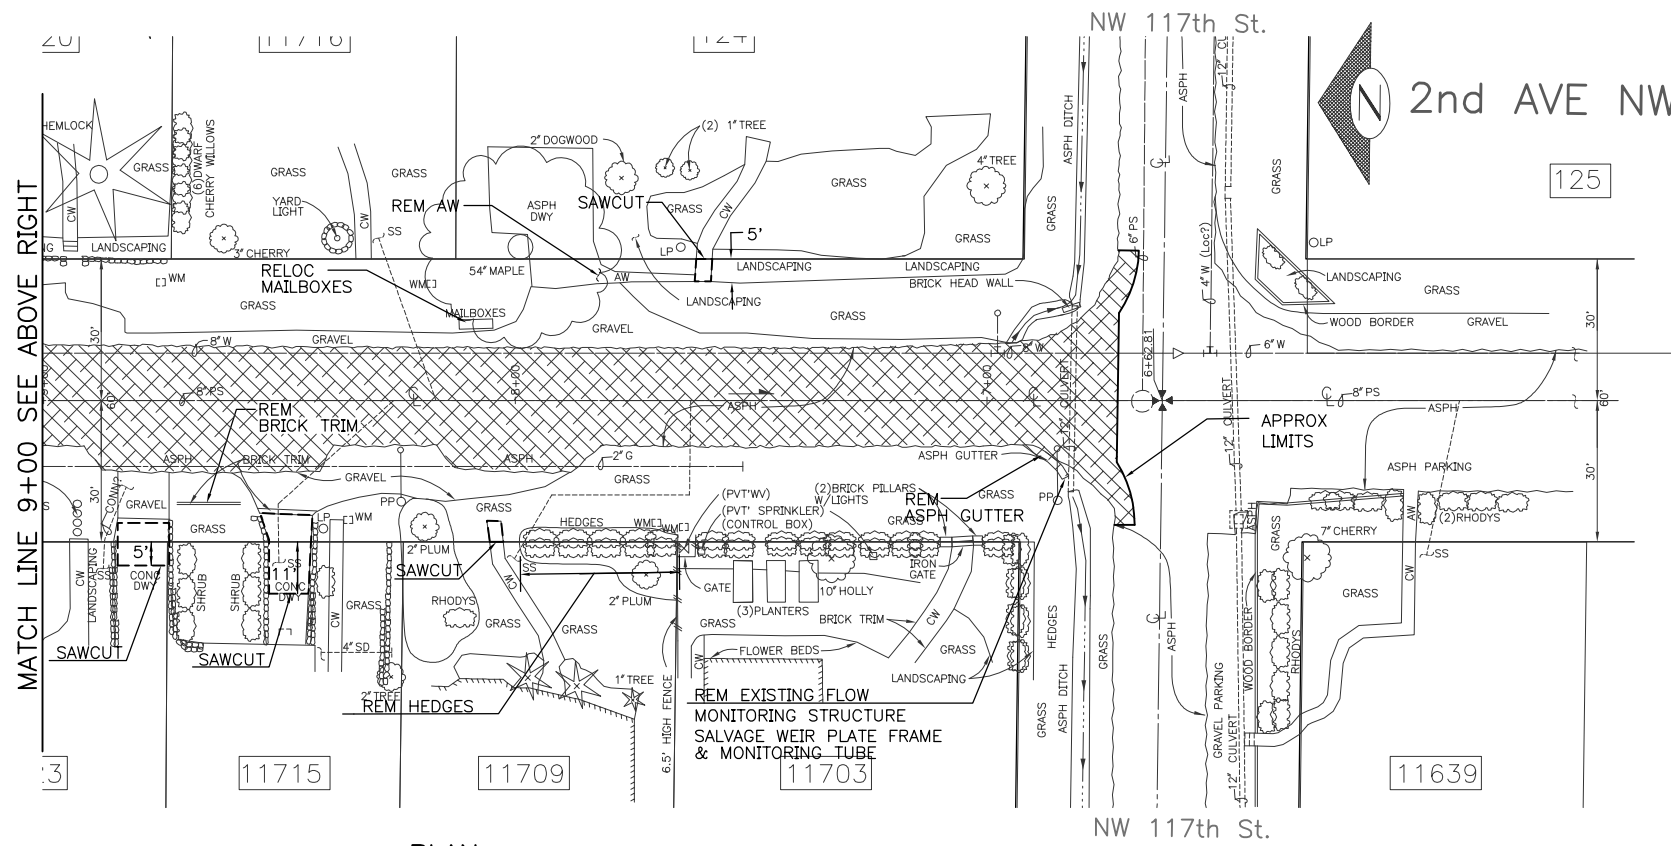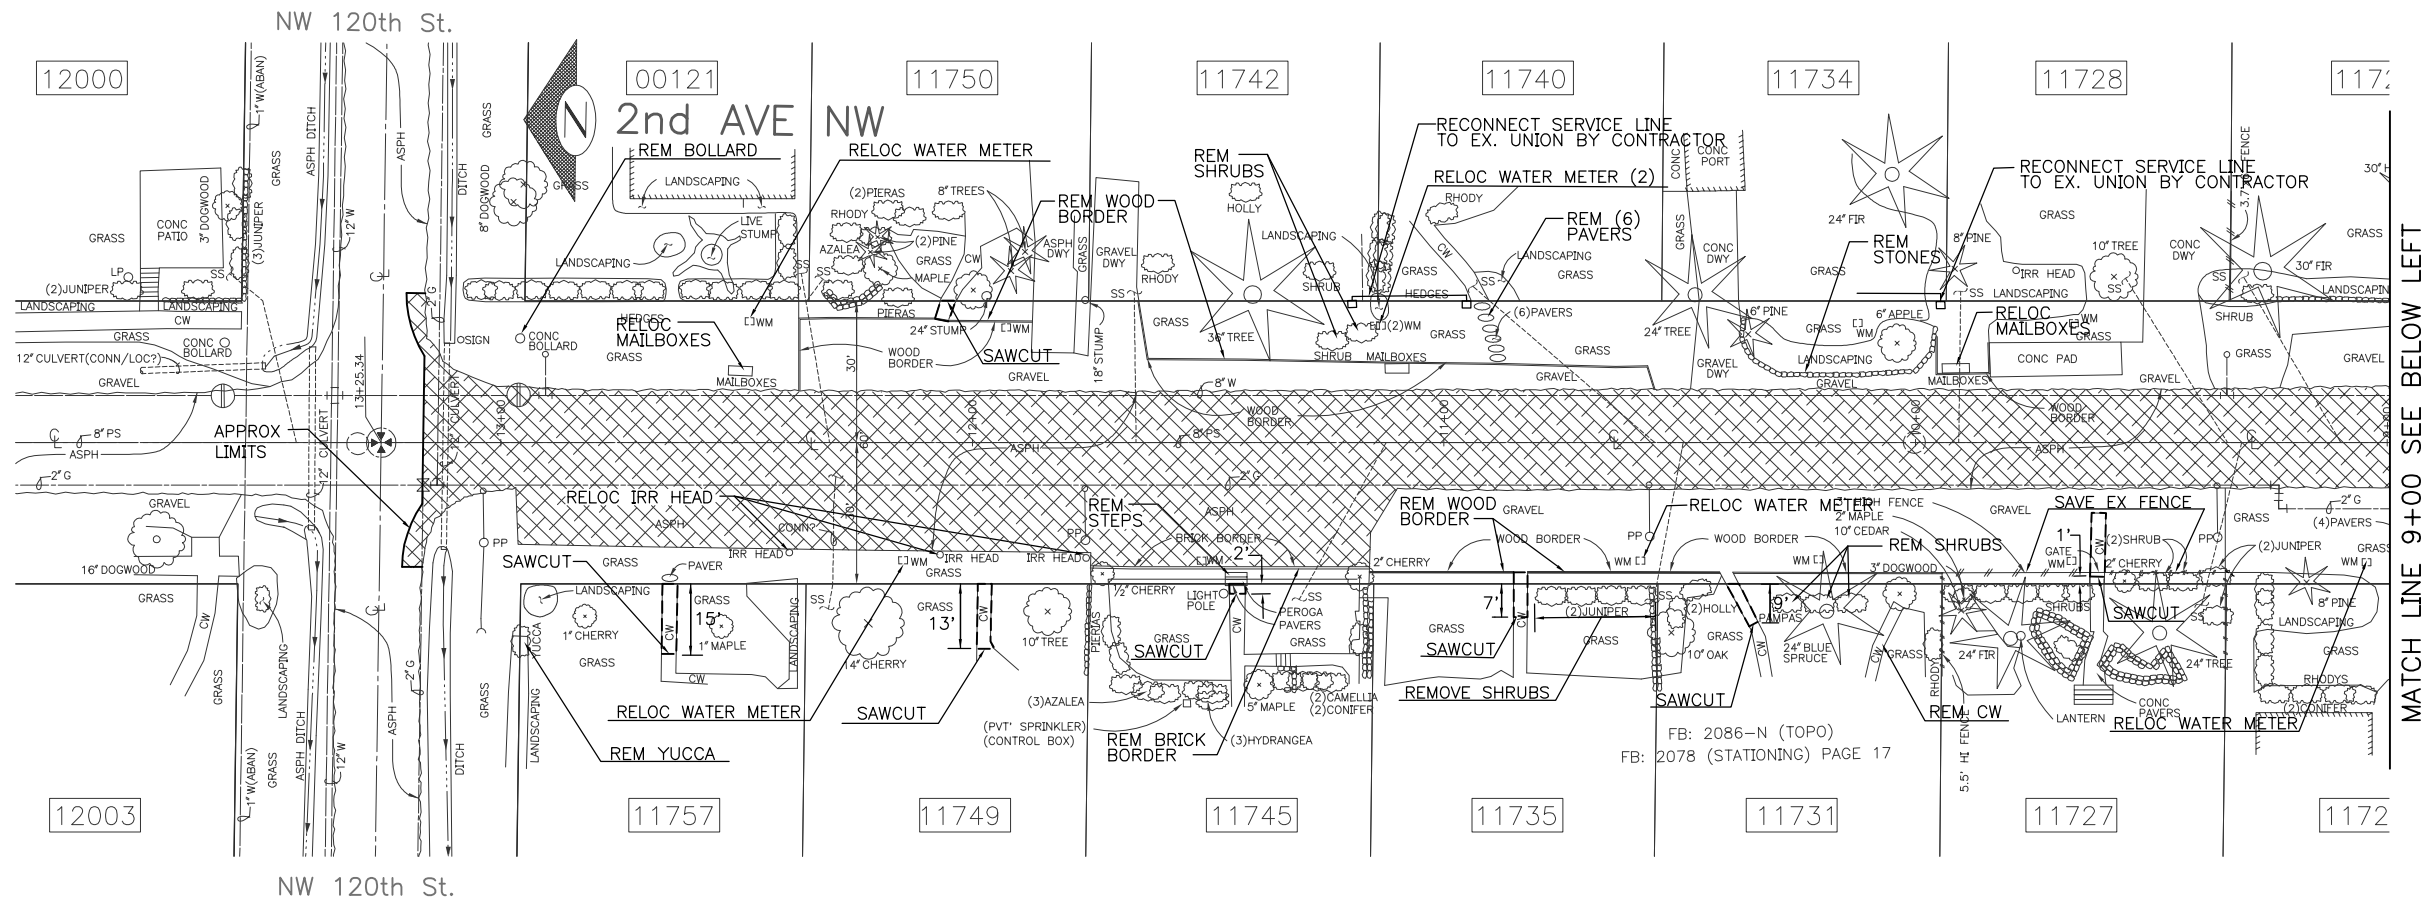

LEGEND

 REMOVE ASPH

 SAWCUT/REMOVE

NOTE:

WATER METERS SHALL BE ADJUSTED
BY SPU

FOR PAVING PLAN, SEE SHEET 10&11
FOR DRAINAGE PLAN, SEE SHEET 3&4
FOR LANDSCAPING PLAN, SEE SHEET 12&13

REMOVAL & RELOCATION PLAN

S.E.A. STREET
2nd AVE NW
(NW 117TH TO NW 120TH)

JOB NO.	PC	C399312
	R/W	
	CO	C399312
VAULT PLAN NO. 777-162		
SHEET 2 OF 14		


RECORD DRAWING

PLAN

APPROVED FOR ADVERTISING
DWIGHT DIVELY
EXECUTIVE SERVICES DIRECTOR
SEATTLE, WASHINGTON 20

BY:
CONTRACTING MANAGER

NAME OR INITIALS AND DATE		INITIALS AND DATE	
DESIGNED		REVIEWED:	
CHECKED		DES.	CONST.
		SEATPLAN	PROJ. MGR.
DRAWN		RECEIVED	
CHECKED		REVISED AS BUILT	
ALL WORK DONE IN ACCORDANCE WITH THE CITY OF SEATTLE STANDARD PLANS AND SPECIFICATIONS AND OTHER DOCUMENTS CALLED FOR IN SECTION 0-02.3 OF THE PROJECT MANUAL.			


City of Seattle
Seattle Public Utilities
Diana Gale, Director
 ORDINANCE NO. _____
 FUND: _____
 SCALE: H 1" = 20' _____
 INSPECTOR'S BOOK _____

S.E.A. STREET
2nd AVE NW

P:\RecordDrawings\C399312\SWTD5_P.dwg rainwab 09/21/00 09:35 AM


Vault Serial No.	Date	Mark	Nature	Made Chkd	Rev'd
33655			REVISIONS		

RECORD DRAWING

APPROVED FOR ADVERTISING
DWIGHT DIVELY
EXECUTIVE SERVICES DIRECTOR
SEATTLE, WASHINGTON 20

BY:
CONTRACTING MANAGER

NAME OR INITIALS AND DATE	INITIALS AND DATE
DESIGNED	REVIEWED:
CHECKED	DES. CONST.
	SEATRAN PROJ. MGR.
DRAWN	RECEIVED
CHECKED	REVISED AS BUILT
ALL WORK DONE IN ACCORDANCE WITH THE CITY OF SEATTLE STANDARD PLANS AND SPECIFICATIONS AND OTHER DOCUMENTS CALLED FOR IN SECTION 0-02.3 OF THE PROJECT MANUAL.	



City of Seattle

Seattle Public Utilities

Diana Gale, Director

ORDINANCE NO.

APPROVED

FUND:


SCALE: H 1"=20' V 1"=10' INSPECTOR'S BOOK

S.E.A. STREET
2nd AVE NW
(NW 117TH TO NW 120TH)

JOB NO. PC C399312
R/W CO C399312
VAULT PLAN NO. 777-162
SHEET 5 OF 14

360 370 380 390 400


MATCH LINE 10+20 SEE ABOVE RIGHT

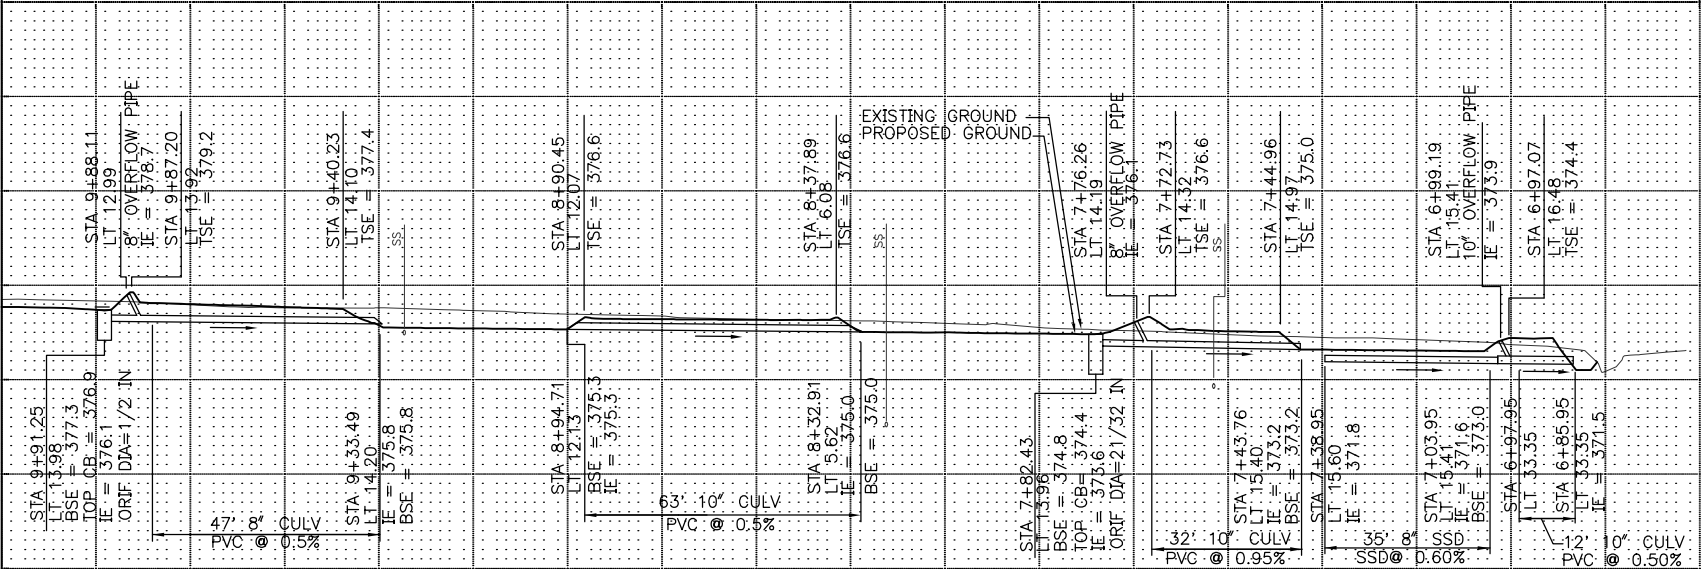

PROFILE WEST SIDE STREET


360 370 380 390 400

MATCH LINE 10+20 SEE BELOW LEFT

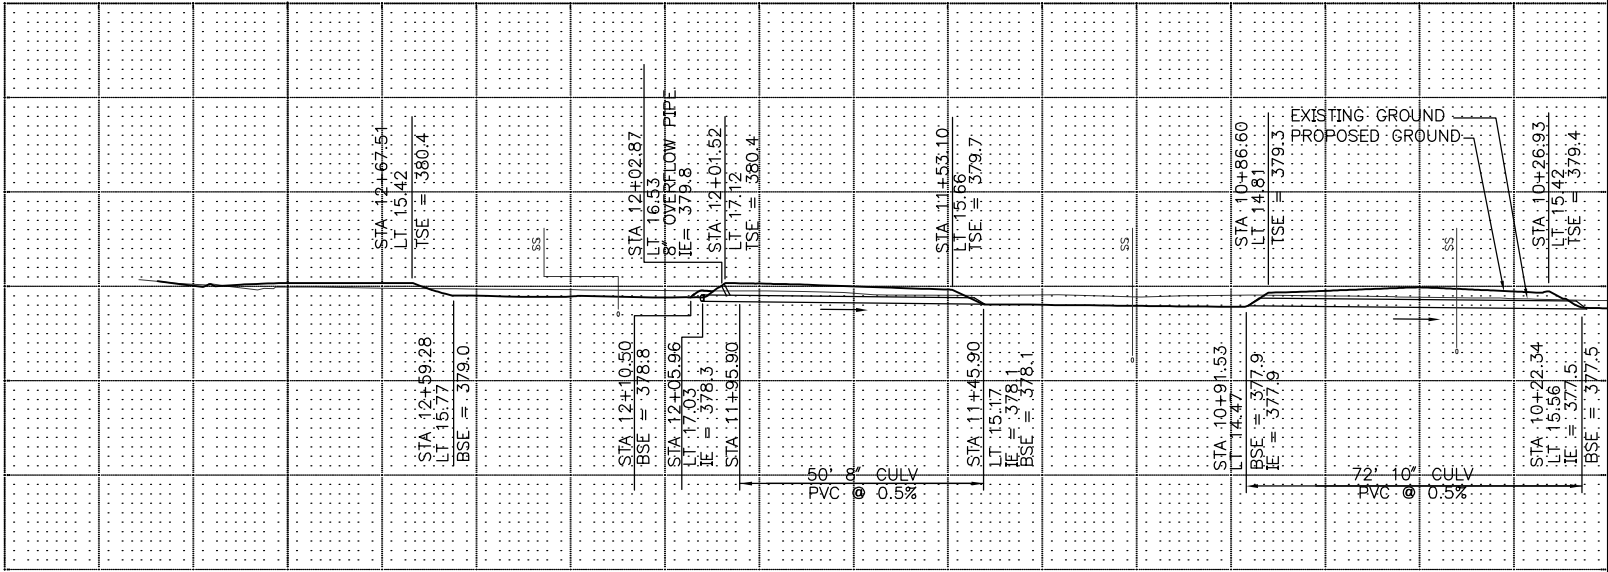


[illegible]


P:\RecordDrawings\C399312\SWT06__P.dwg rainwab 09/21/00 09:36 AM

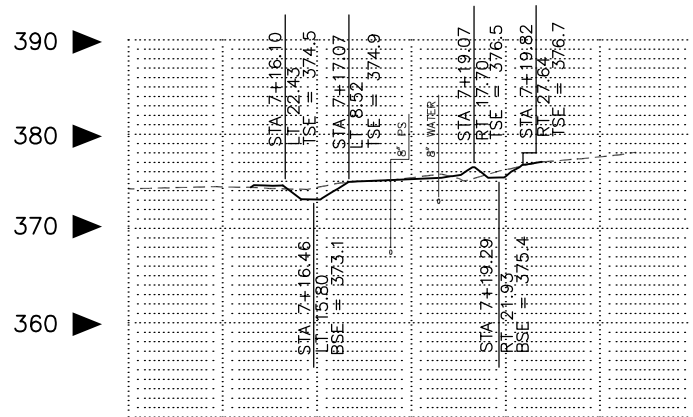


SECTION A-A: VEGETATED
SWALE W6,E6

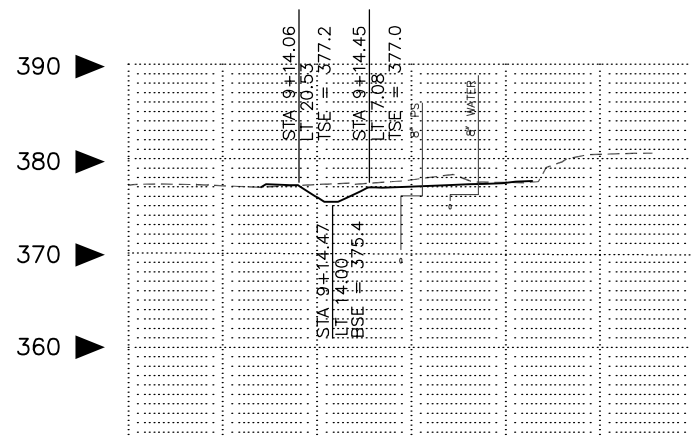


SECTION D-D: VEGETATED
SWALE W4

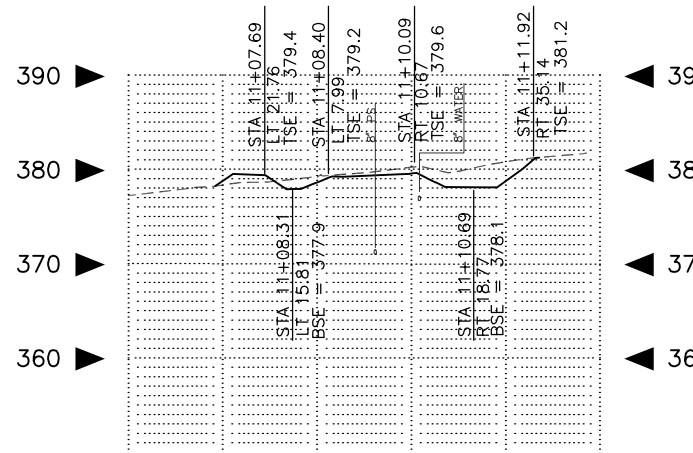


SECTION G-G: VEGETATED
SWALE W2,E2

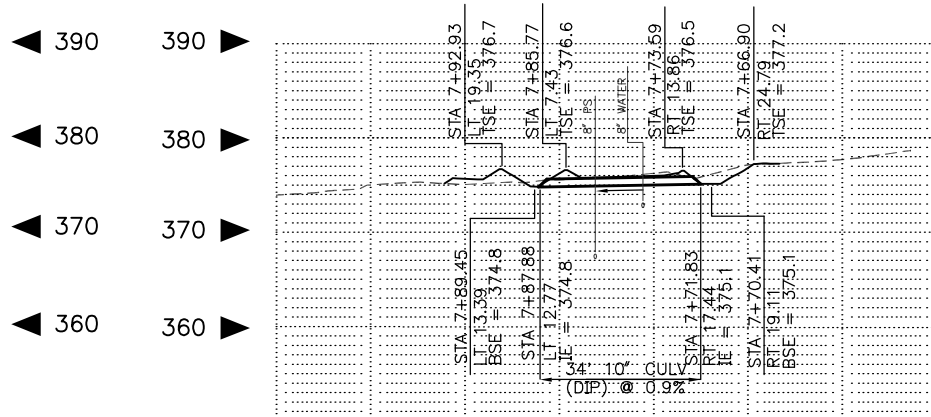


SECTION B-B: VEGETATED
SWALE W5,E6

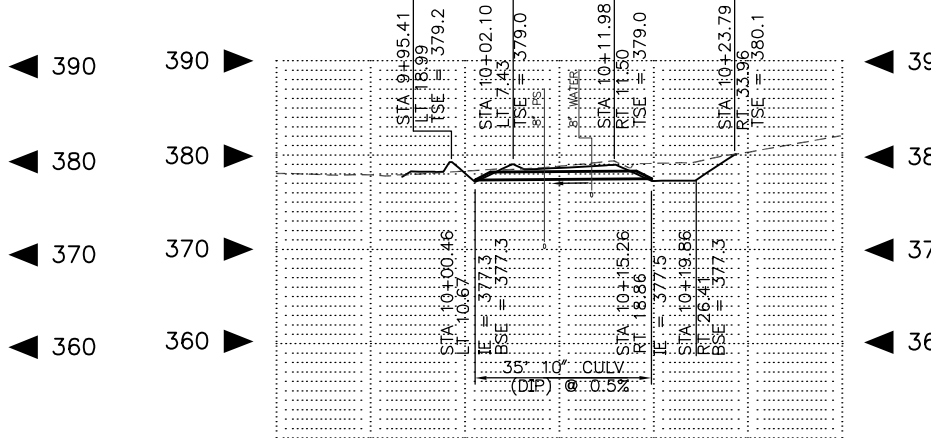


SECTION E-E: VEGETATED
SWALE W3,E4

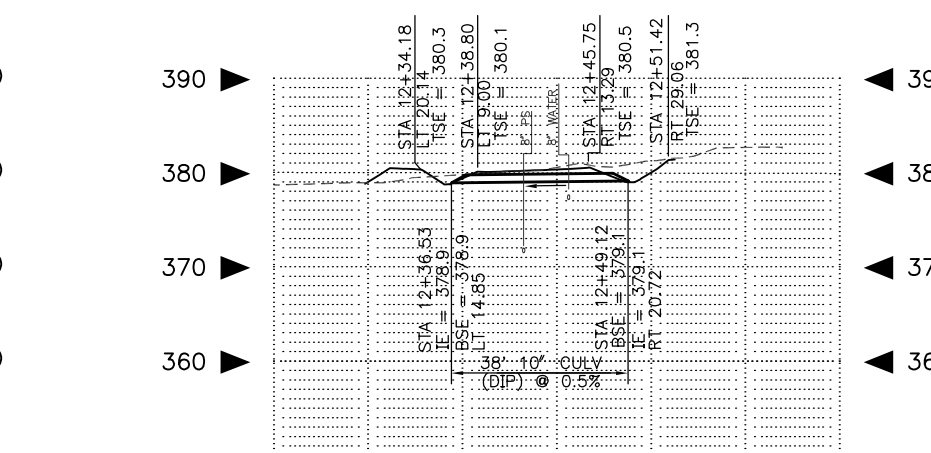

SECTION H-H: VEGETATED
SWALE W1,E1

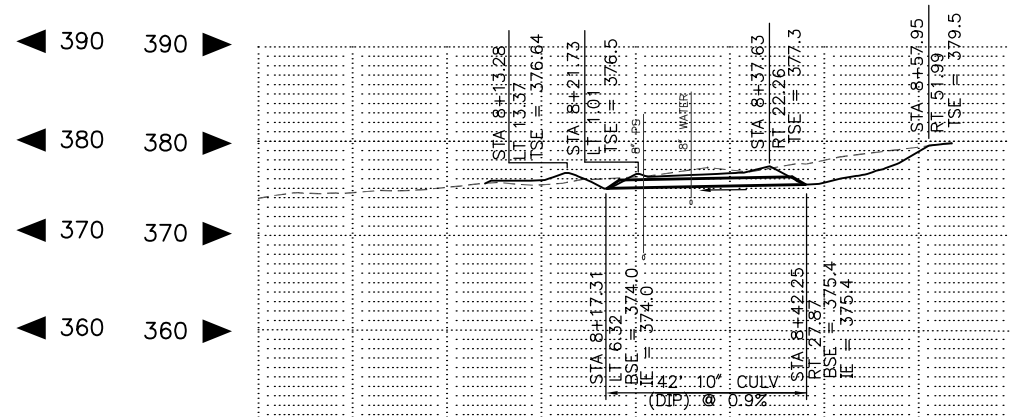

SECTION C-C: VEGETATED
SWALE W5,E5

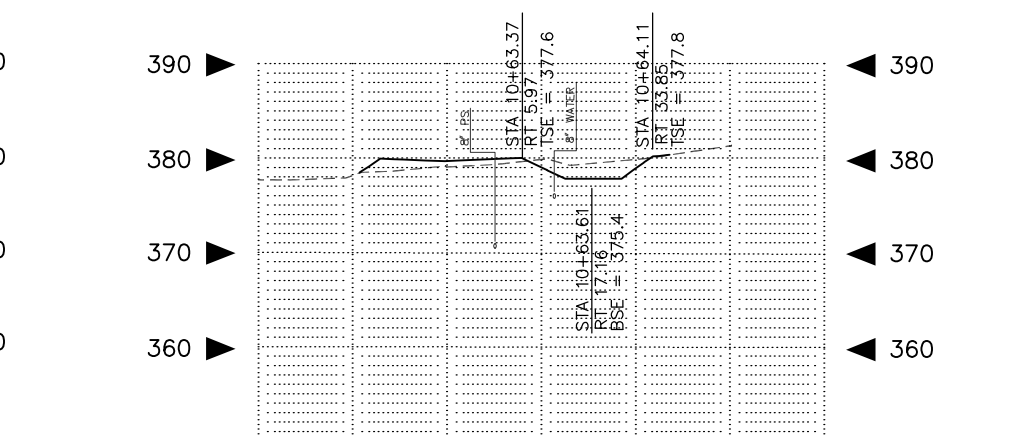


SECTION F-F: VEGETATED
SWALE E5

RECORD DRAWING

APPROVED FOR ADVERTISING
DWIGHT DIVELY
EXECUTIVE SERVICES DIRECTOR
SEATTLE, WASHINGTON 20

BY:
CONTRACTING MANAGER

NAME OR INITIALS AND DATE		INITIALS AND DATE	
DESIGNED		REVIEWED:	
CHECKED		DES.	CONST.
		SEATRAN	PROJ. MGR.
DRAWN		RECEIVED	
CHECKED		REVISED AS BUILT	
ALL WORK DONE IN ACCORDANCE WITH THE CITY OF SEATTLE STANDARD PLANS AND SPECIFICATIONS AND OTHER DOCUMENTS CALLED FOR IN SECTION 0-02.3 OF THE PROJECT MANUAL.			

 City of Seattle
Seattle Public Utilities
Diana Gale, Director

ORDINANCE NO. _____ APPROVED _____

FUND: _____

SCALE: H 1"=20' V 1"=10' INSPECTOR'S BOOK

S.E.A. STREET
2nd AVE NW
(NW 117TH TO NW 120TH)


JOB NO.	PC	C399312
	R/W CO	C399312
VAULT PLAN NO. 777-162		
SHEET 6 OF 14		

CROSS SECTION DETAILS


Vault	Serial No.	Date	Mark	Nature	Revisions	Made	Checked	Rev'd
	33655							

P:\RecordDrawings\C399312\SWT06_P.dwg rainwab 09/21/00 09:36 AM


RECORD DRAWING

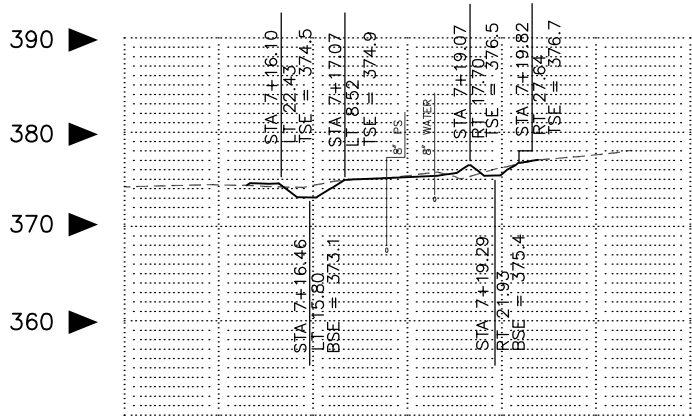


SECTION A-A: VEGETATED
SWALE W6.E6

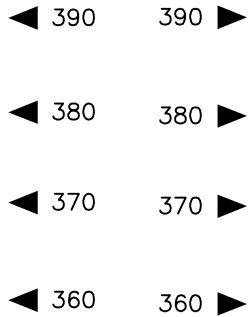


SECTION B-B: VEGETATED
SWALE W5.E6

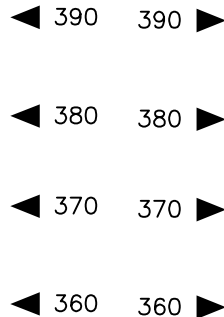


SECTION C-C: VEGETATED
SWALE W5.E5

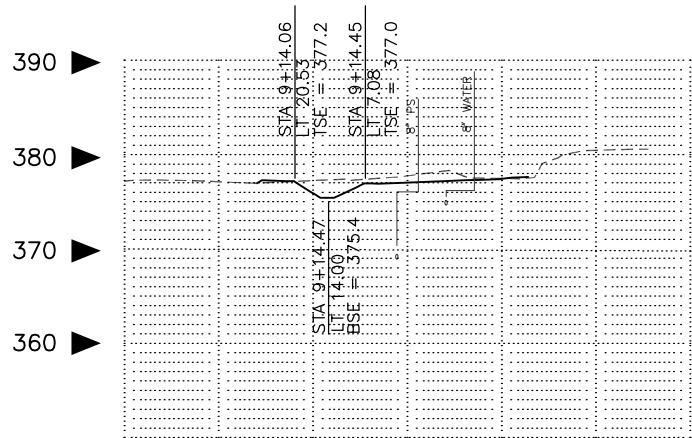


SECTION D-D: VEGETATED
SWALE W4

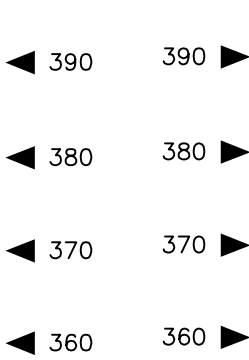


SECTION E-E: VEGETATED
SWALE W3.E4

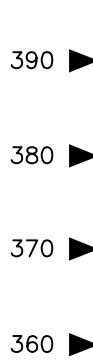


SECTION F-F: VEGETATED
SWALE E5

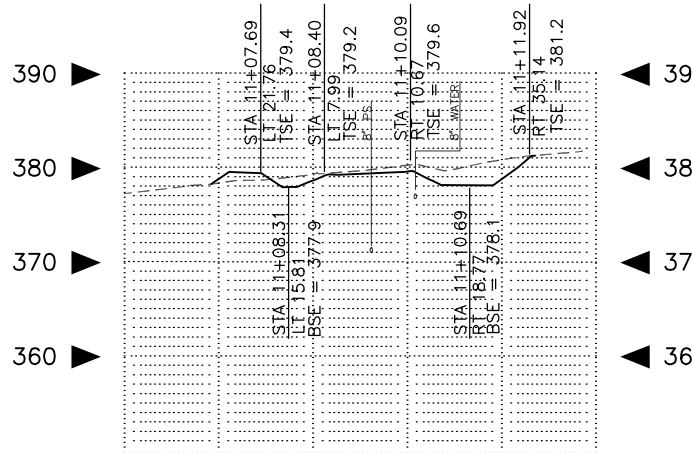

SECTION G-G: VEGETATED
SWALE W2.E2

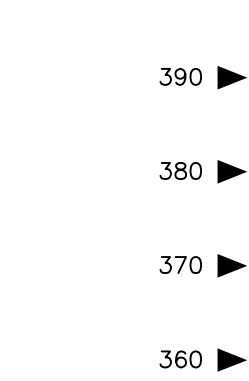

SECTION H-H: VEGETATED
SWALE W1.E1

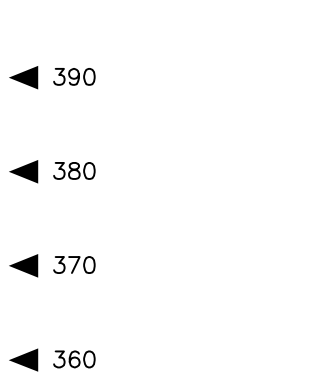

CROSS SECTION DETAILS

APPROVED FOR ADVERTISING
DWIGHT DIVELY
EXECUTIVE SERVICES DIRECTOR
SEATTLE, WASHINGTON 20

BY: CONTRACTING MANAGER

NAME OR INITIALS AND DATE
DESIGNED
CHECKED

DRAWN
CHECKED

INITIALS AND DATE
REVIEWED:
DES. CONST.
SEATRAIN PROJ. MGR.

RECEIVED
REVISED AS BUILT

ALL WORK DONE IN ACCORDANCE WITH THE CITY OF SEATTLE STANDARD PLANS AND SPECIFICATIONS AND OTHER DOCUMENTS CALLED FOR IN SECTION 0-02.3 OF THE PROJECT MANUAL.

City of Seattle
Seattle Public Utilities
Diana Gale, Director



ORDINANCE NO. APPROVED

FUND:


SCALE: H 1"=20' V 1"=10' INSPECTOR'S BOOK

S.E.A. STREET
2nd AVE NW
(NW 117TH TO NW 120TH)

PC C399312
R/W
CO C399312
VAULT PLAN NO.
777-162
SHEET 6 OF 14

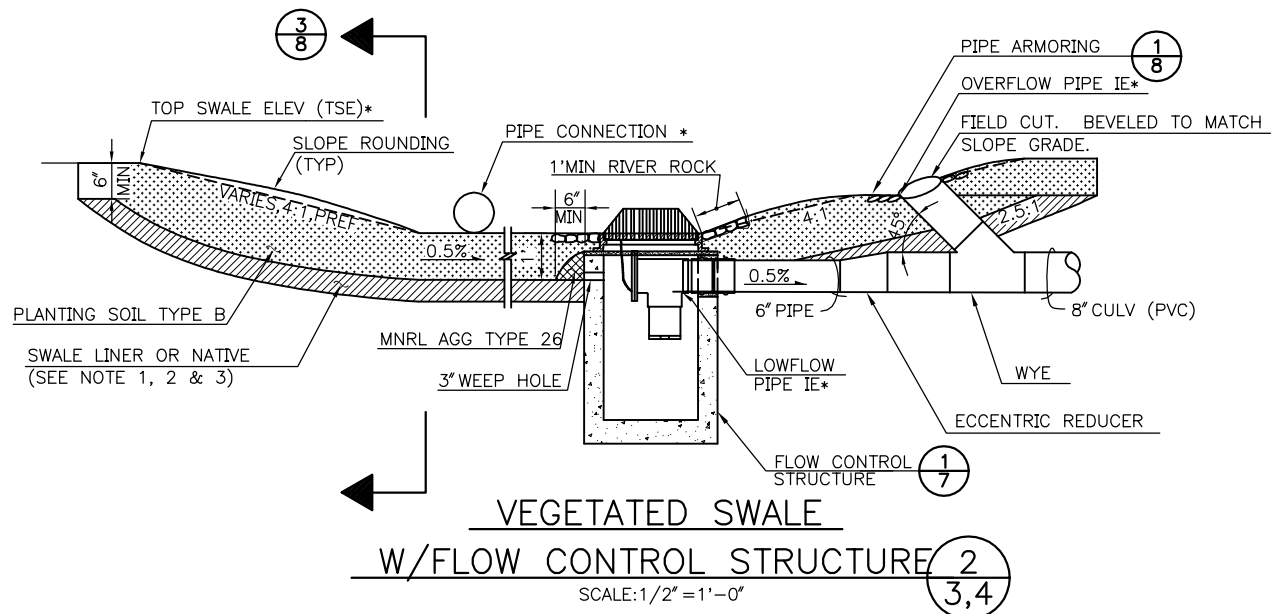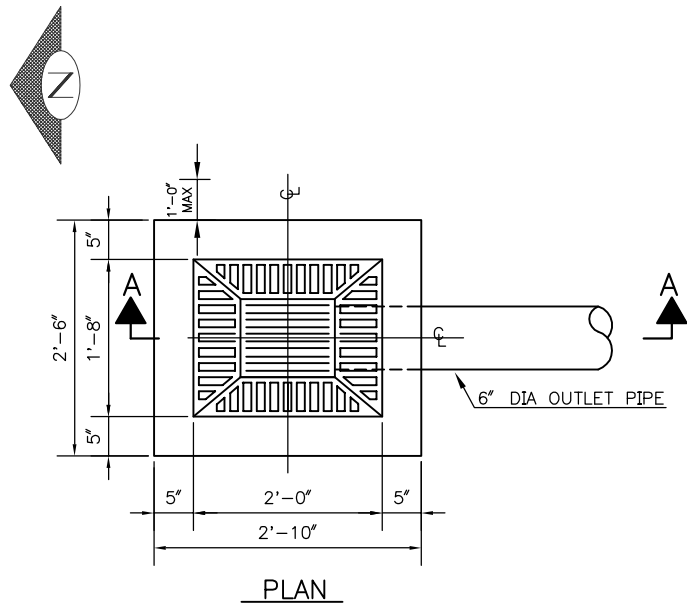


DATE	MARK	NATURE	REVISIONS	MADE	CHK'D	REV'D
3/3/55						

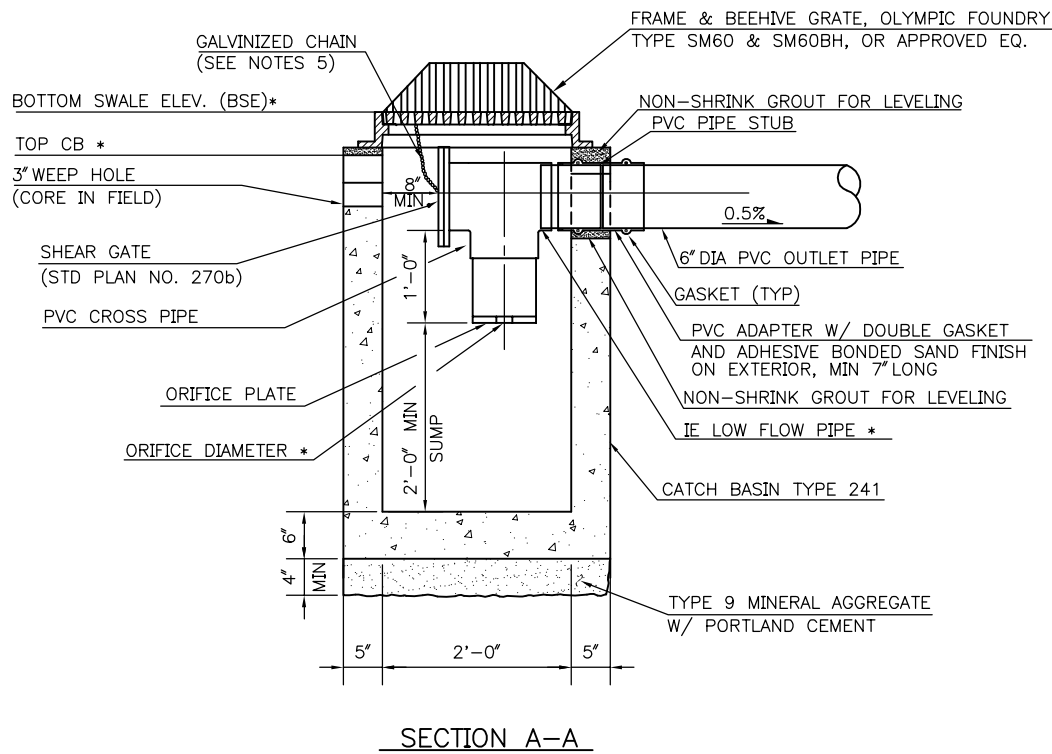

FLOW CONTROL
STRUCTURE (1)

SCALE: 1" = 1'-0"


3,4

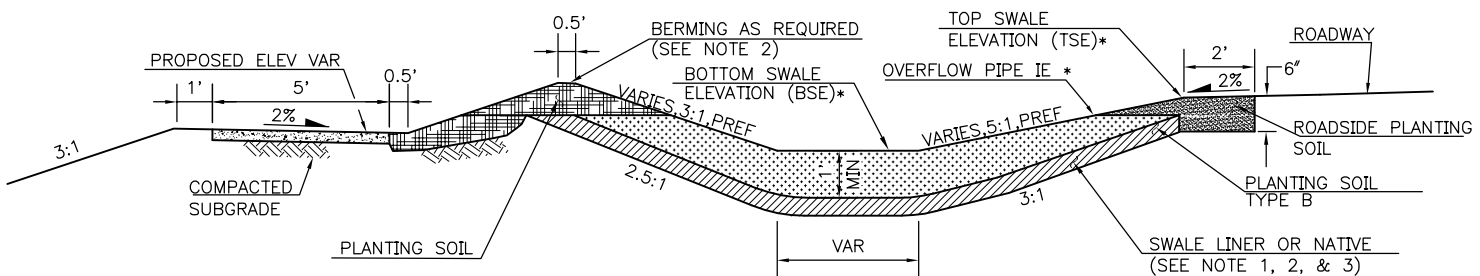

CROSS-SECTION VEGETATED SWALE (TYP) (3)

SCALE: 3/8" = 1'-0"

3,4

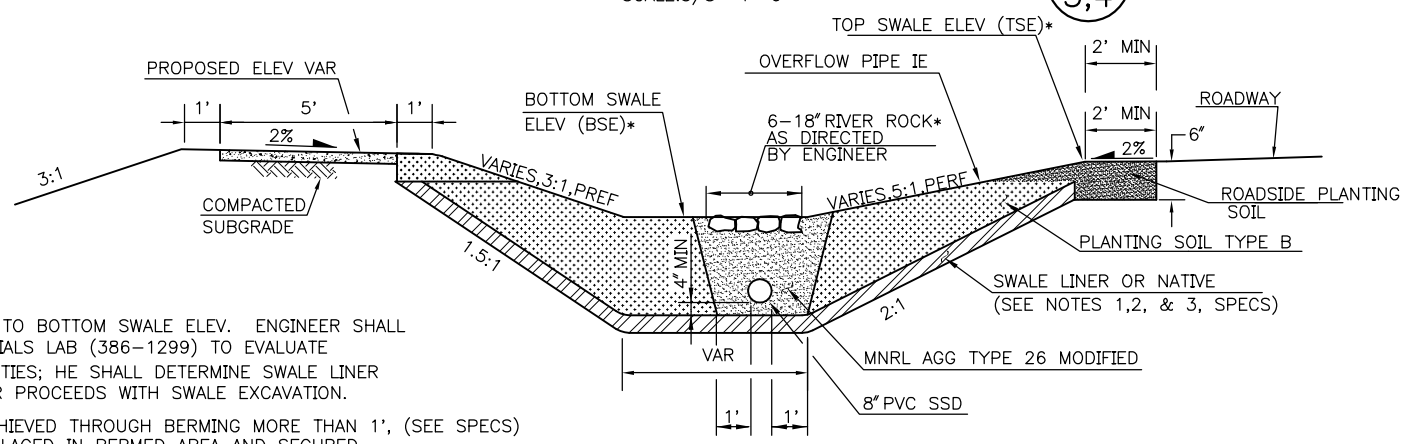

CROSS-SECTION
VEGETATED SWALE W/ SUB SURFACE DRAIN (4)

SCALE: 3/8" = 1'-0"

3,4


- NOTES:
- CONTRACTOR SHALL EXCAVATE TO BOTTOM SWALE ELEV. ENGINEER SHALL CONTACT AL RICE, SPU MATERIALS LAB (386-1299) TO EVALUATE NATIVE SOIL MATERIAL PROPERTIES; HE SHALL DETERMINE SWALE LINER MATERIAL BEFORE CONTRACTOR PROCEEDS WITH SWALE EXCAVATION.
 - WHEN TOP SWALE ELEV. IS ACHIEVED THROUGH BERMING MORE THAN 1', (SEE SPECS) PVC SWALE LINER SHALL BE PLACED IN BERMED AREA AND SECURED.
 - SWALE LINER SHALL EXTEND, AT MINIMUM, TO ELEV. OF OVERFLOW PIPE IE.
 - ALL EXPOSED PIPE ENDS SHALL USE PIPE ARMORING. (1/8)
 - GALVANIZED CHAIN SHALL BE CONNECTED TO DRIFT WOOD (PROVIDE BY OTHERS).
- * SPECIFIC DESIGN INFORMATION AS INDICATED ON PLAN SHEETS.

RECORD DRAWING


DRAINAGE DETAILS SHEET

<p>APPROVED FOR ADVERTISING DWIGHT DIVELY EXECUTIVE SERVICES DIRECTOR SEATTLE, WASHINGTON 20</p> <p>BY: CONTRACTING MANAGER</p>	<p>NAME OR INITIALS AND DATE DESIGNED CHECKED</p> <p>DRAWN CHECKED</p> <p>ALL WORK DONE IN ACCORDANCE WITH THE CITY OF SEATTLE STANDARD PLANS AND SPECIFICATIONS AND OTHER DOCUMENTS CALLED FOR IN SECTION 0-02.3 OF THE PROJECT MANUAL.</p>	<p>INITIALS AND DATE REVIEWED: DES. CONST. SEATRAN PROJ. MGR.</p> <p>RECEIVED</p> <p>REVISED AS BUILT</p>	<p>City of Seattle Seattle Public Utilities Diana Gale, Director</p> <p>ORDINANCE NO. APPROVED</p> <p>FUND:</p> <p>SCALE: AS SHOWN INSPECTOR'S BOOK</p>	<p>S.E.A. STREET 2nd AVE NW (NW 117TH TO NW 120TH)</p>	<p>PC C399312 R/W CO C399312 VAULT PLAN NO. 777-162 SHEET 7 OF 14</p>
---	--	---	--	--	---


P:\RecordDrawings\C399312\SWT07_P.dwg rainwab 09/21/00 09:37 AM

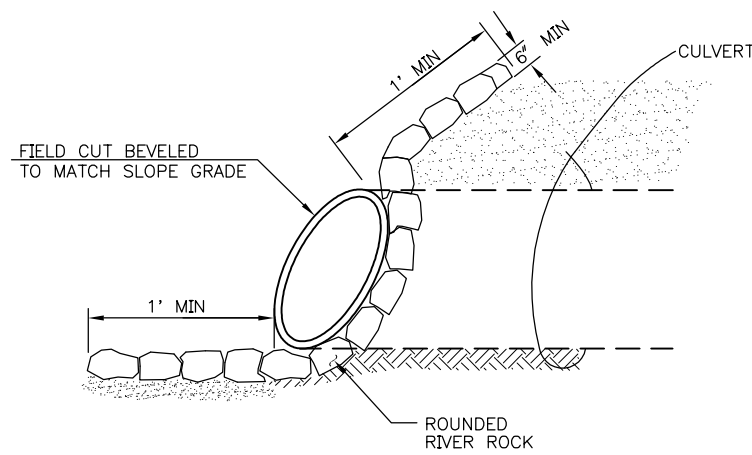


PIPE ARMORING 1
3,4
N.T.S.

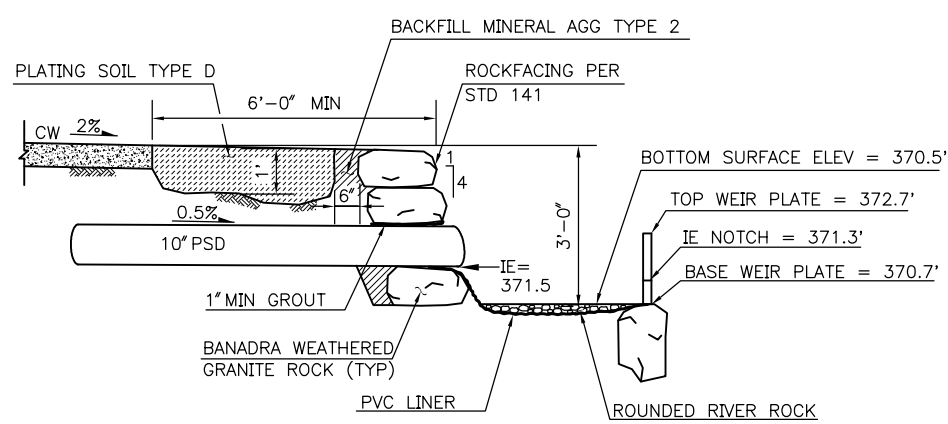


SECTION A-A

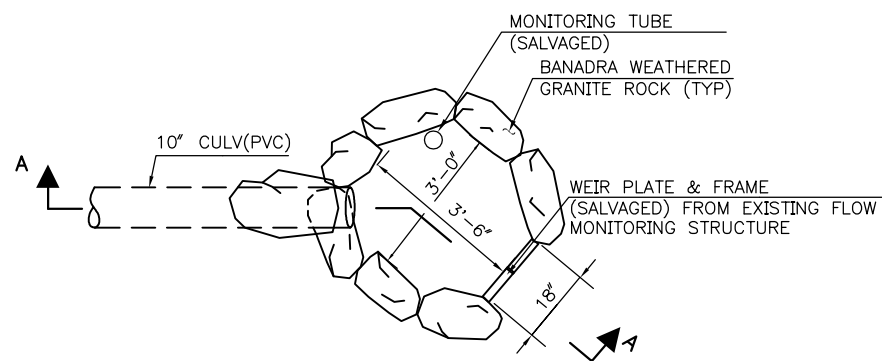


FLOW MONITORING POOL 3
4
SCALE: 1/2" = 1'-0"

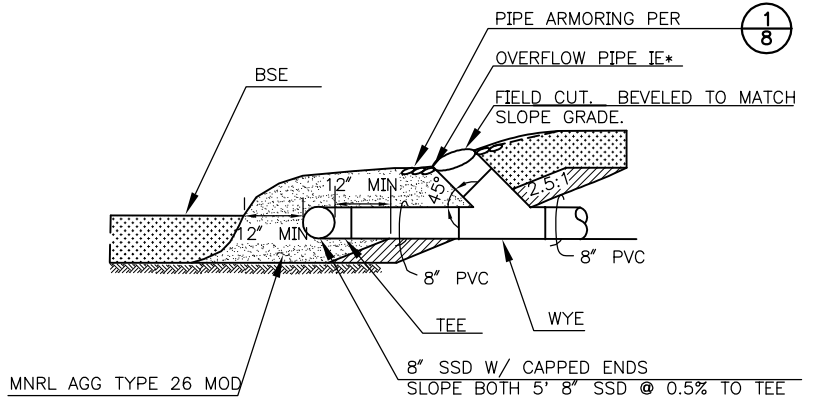


FLOW CONTROL PIPE (W1) 5
3
SCALE: 1/2" = 1'-0"

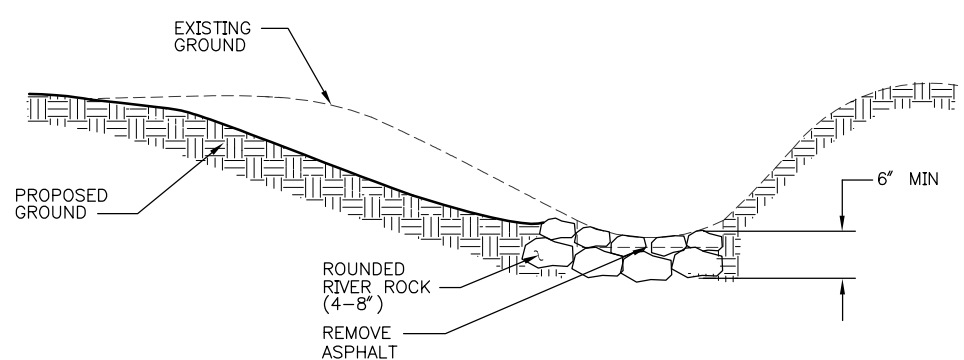

DITCH RETROFIT 2
3,4
N.T.S.

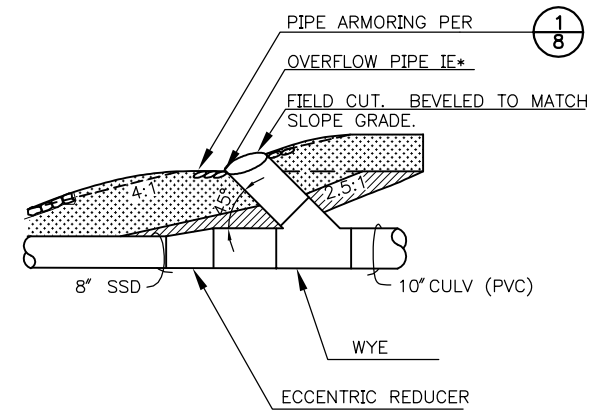

FLOW CONTROL PIPE (W-6) 4
4
SCALE: 1/2" = 1'-0"

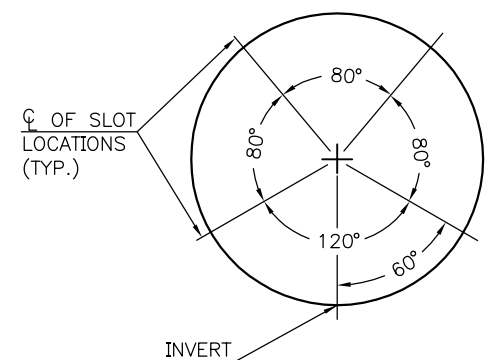

SLOT LOCATION DETAIL 6
8
NO SCALE

DRAINAGE DETAILS SHEET

DATE	MARK	NATURE	REVISIONS

P:\RecordDrawings\C399312\SWT08_P.dwg rainwab 09/21/00 09:38 AM VULT SERIAL NO. 33655

RECORD DRAWING

APPROVED FOR ADVERTISING DWIGHT DIVELY EXECUTIVE SERVICES DIRECTOR SEATTLE, WASHINGTON 20		NAME OR INITIALS AND DATE DESIGNED CHECKED	INITIALS AND DATE REVIEWED: DES. CONST. SEATRAN PROJ. MGR.
BY: CONTRACTING MANAGER		DRAWN CHECKED	RECEIVED REVISED AS BUILT
ALL WORK DONE IN ACCORDANCE WITH THE CITY OF SEATTLE STANDARD PLANS AND SPECIFICATIONS AND OTHER DOCUMENTS CALLED FOR IN SECTION 0-02.3 OF THE PROJECT MANUAL.			

City of Seattle
Seattle Public Utilities
Diana Gale, Director


ORDINANCE NO. APPROVED
FUND:
SCALE: AS SHOWN INSPECTOR'S BOOK

S.E.A. STREET
2nd AVE NW
(NW 117TH TO NW 120TH)

PC C399312
R/W
CO C399312
VAULT PLAN NO. 777-162
SHEET 8 OF 14

NO.	DATE	REVISIONS
1		MADE
2		CHK'D
3		REV'D
4		DESCRIPTION

APPROVED FOR ADVERTISING DWIGHT DIVELY EXECUTIVE SERVICES DIRECTOR SEATTLE, WASHINGTON 20	NAME OR INITIALS AND DATE DESIGNED CHECKED DRAWN CHECKED	INITIALS AND DATE REVIEWED: SPU CONST. SEATRA PROJ. MGR. RECEIVED REVISED AS BUILT
BY: CONTRACTING MANAGER	ALL WORK DONE IN ACCORDANCE WITH THE CITY OF SEATTLE STANDARD PLANS AND SPECIFICATIONS AND OTHER DOCUMENTS CALLED FOR IN SECTION 0-02.3 OF THE PROJECT MANUAL.	


**City of Seattle**
SEATRA
Seattle Transportation


ORDINANCE NO. APPROVED

FUND:


SCALE: H. V. INSPECTOR'S BOOK.


PAVING ALIGNMENT PLAN	
S.E.A. STREETS 2ND AVENUE NW (NW 117TH TO NW 120TH)	
PC R/W CO	C399312 C399312
VAULT PLAN NO. 774-162	
SHEET 9 OF 14	

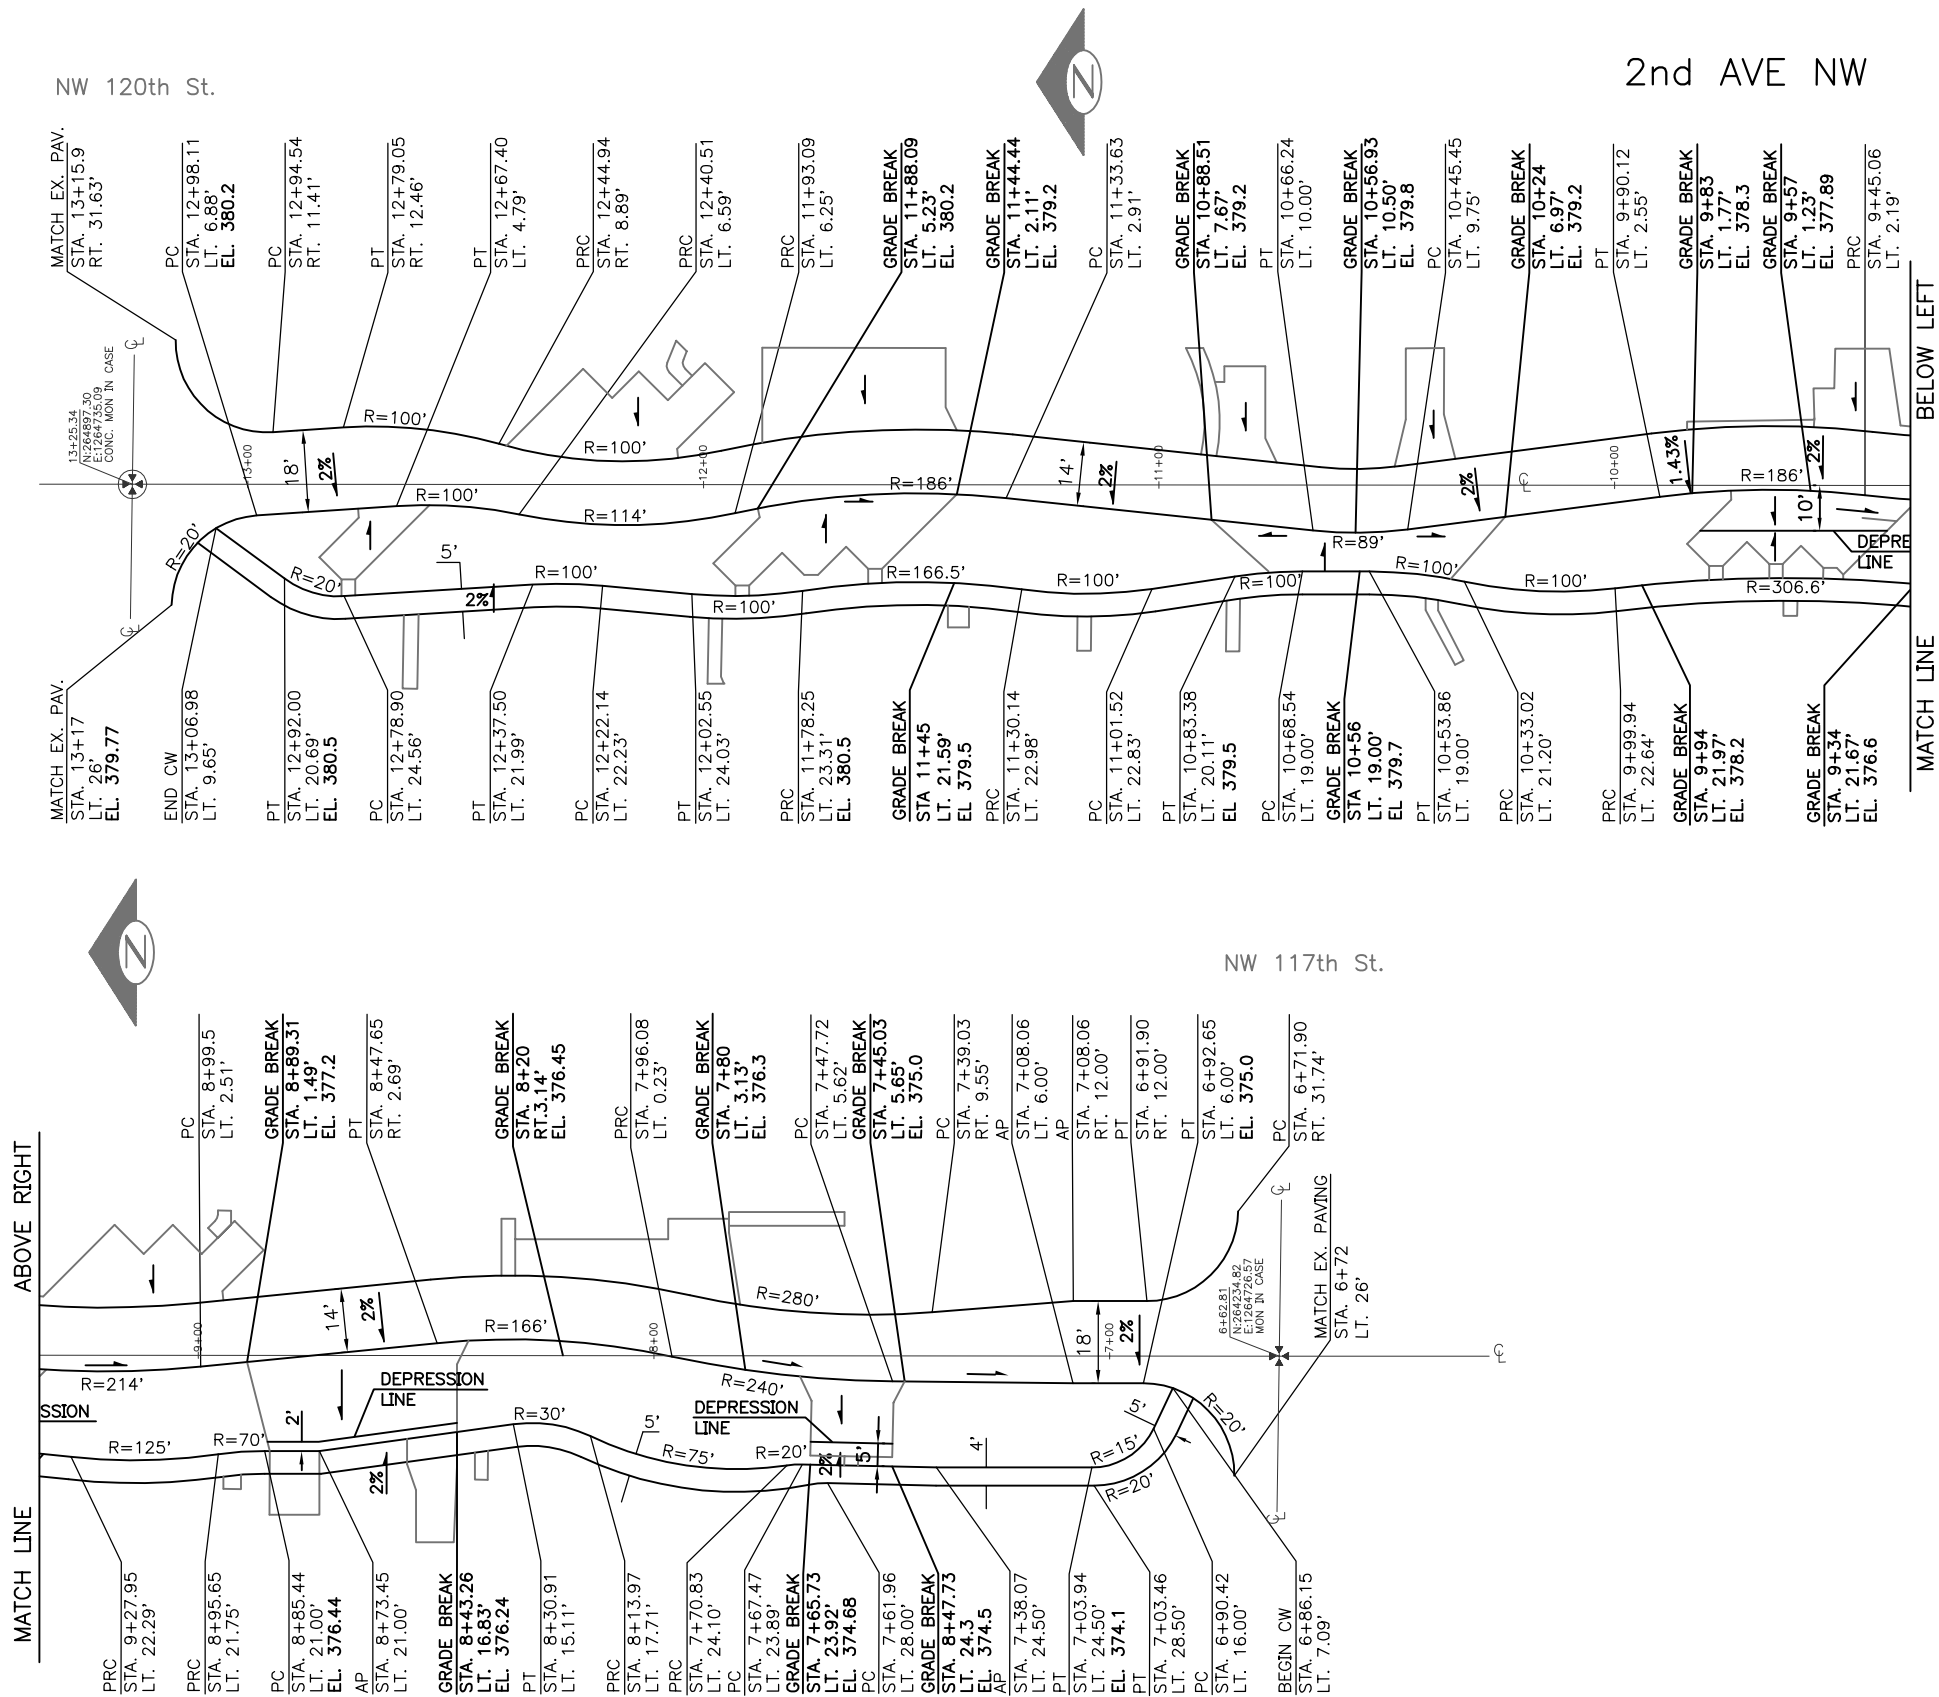


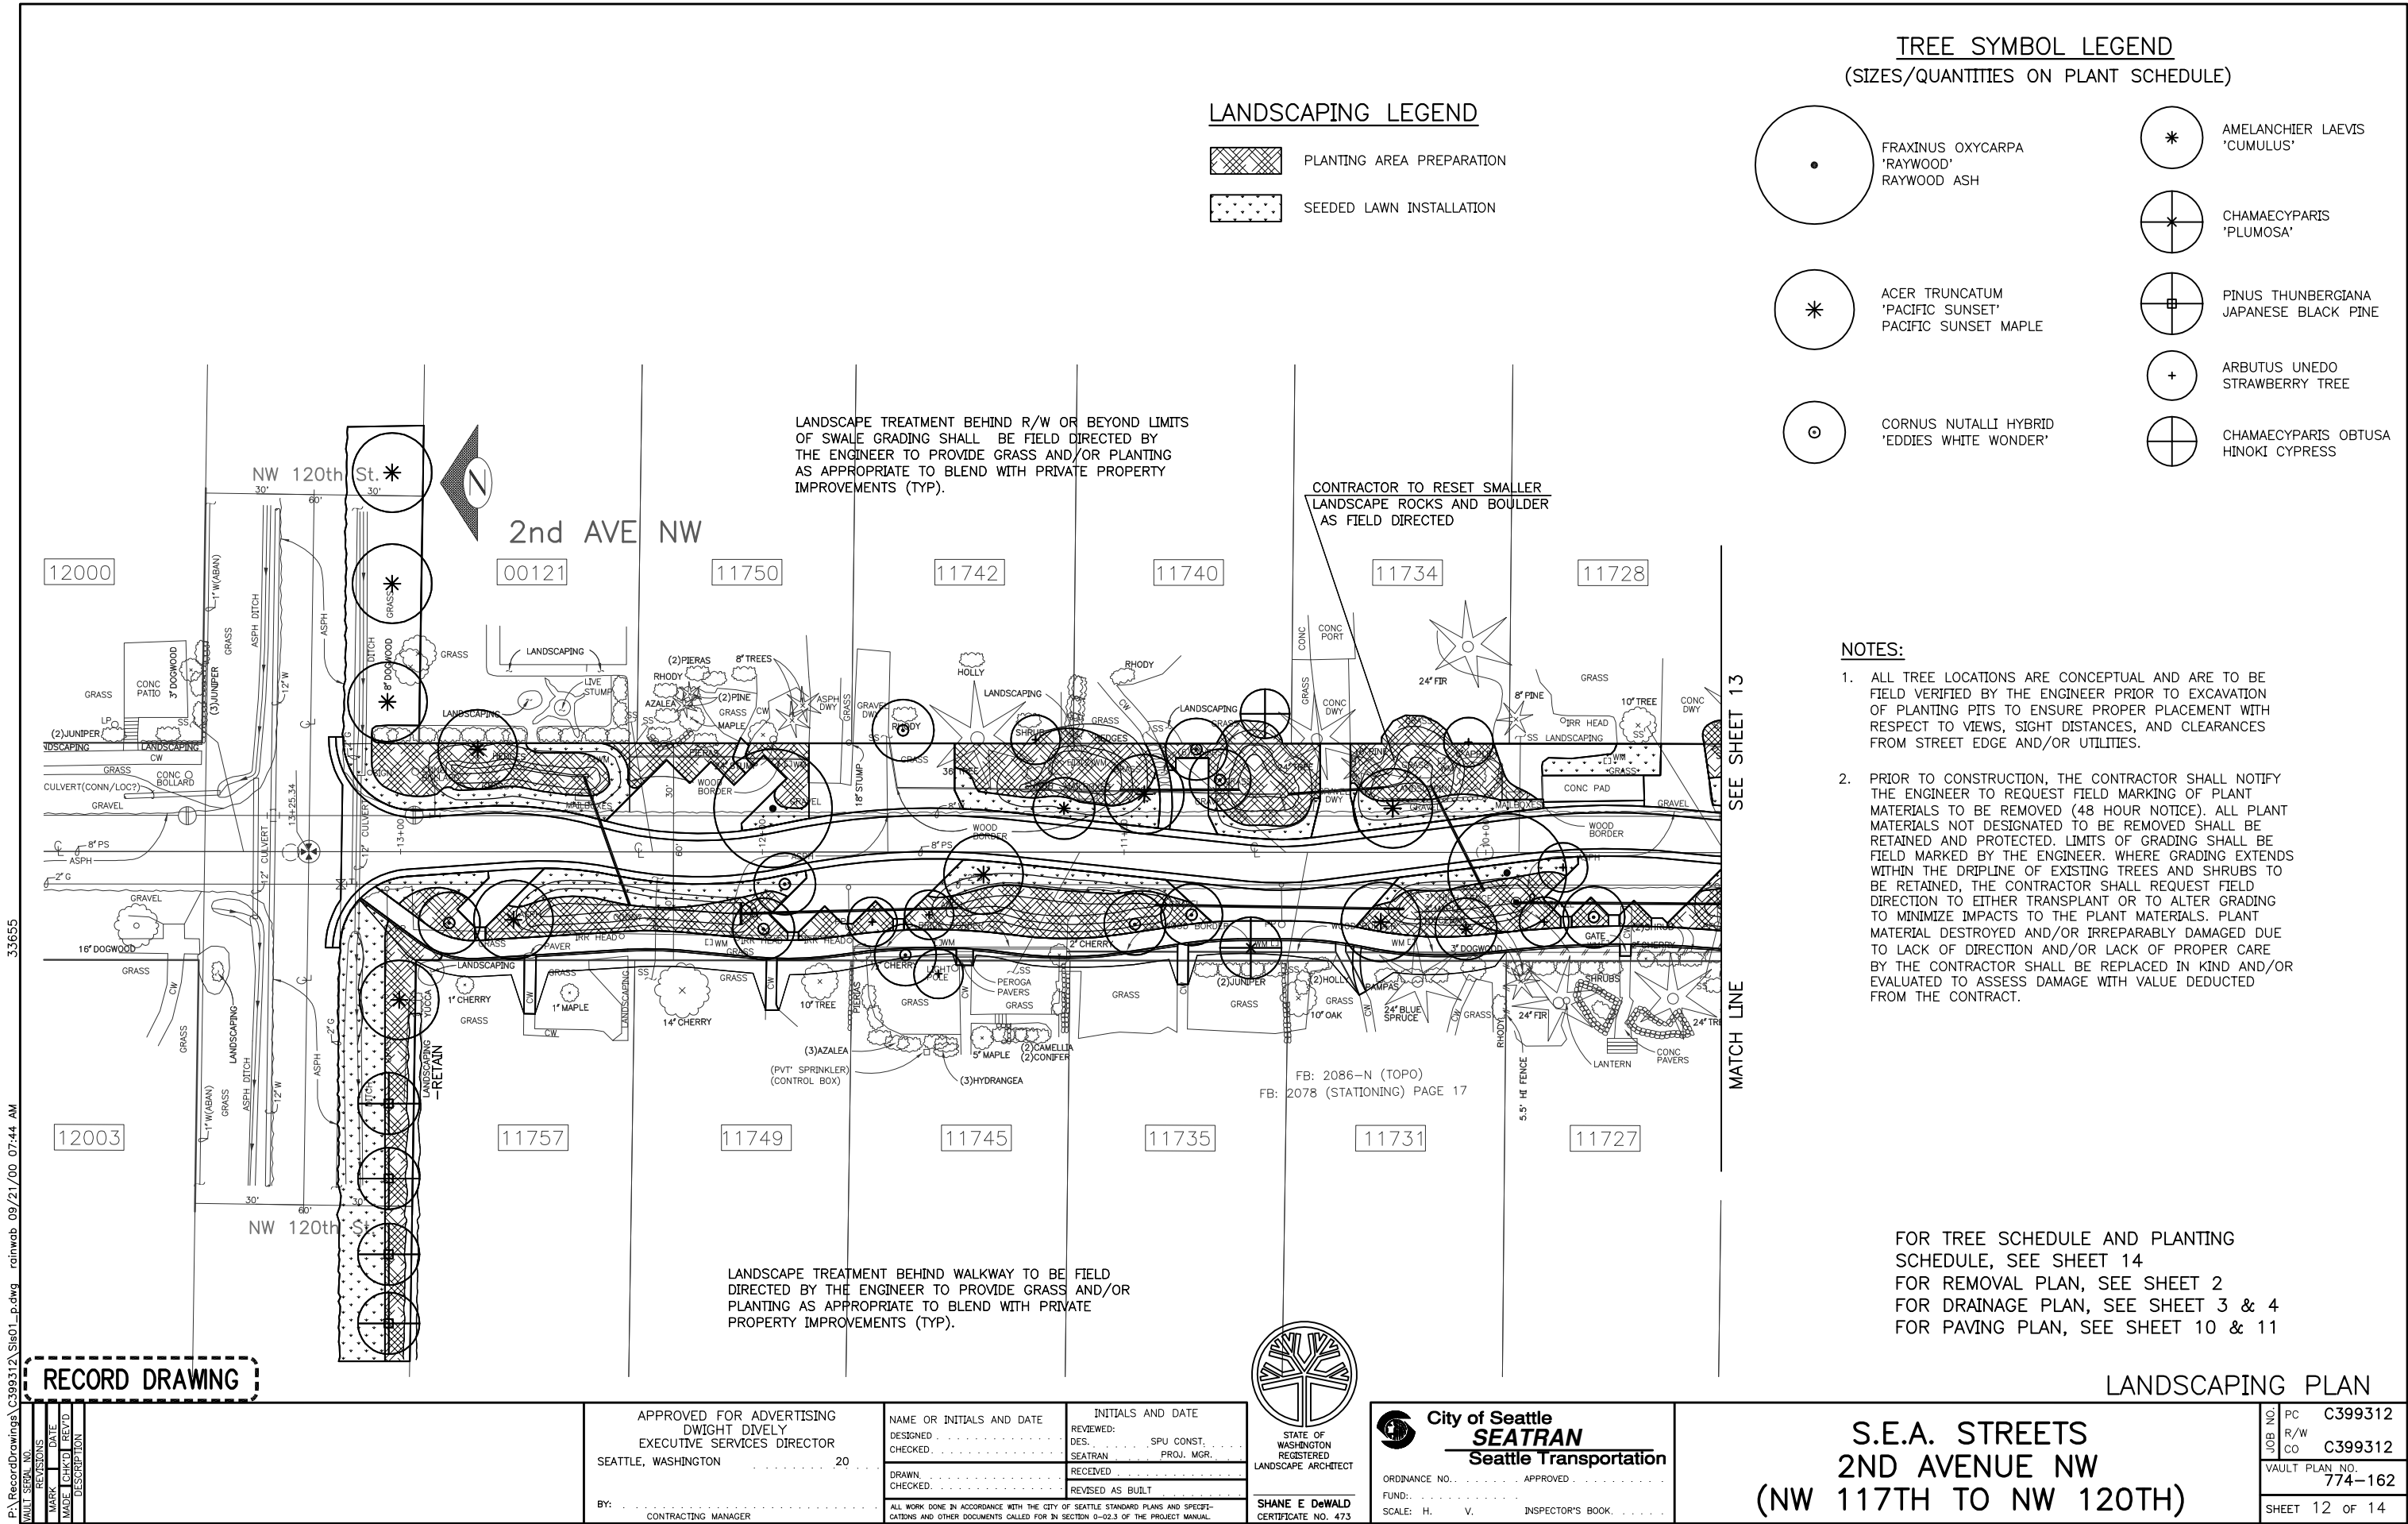



TREE SYMBOL LEGEND
(SIZES/QUANTITIES ON PLANT SCHEDULE)

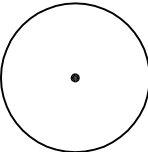
- 

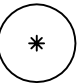
FRAXINUS OXYCARPA
'RAYWOOD'
RAYWOOD ASH
- 

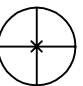
AMELANCHIER LAEVIS
'CUMULUS'
- 

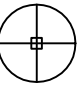CHAMAECYPARIS
'PLUMOSA'
- 

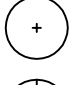PINUS THUNBERGIANA
JAPANESE BLACK PINE
- 


ARBUTUS UNEDO
STRAWBERRY TREE
- 

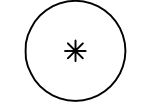CHAMAECYPARIS OBTUSA
HINOKI CYPRESS
- 

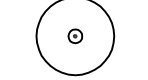ACER TRUNCATUM
'PACIFIC SUNSET'
PACIFIC SUNSET MAPLE
- 

CORNUS NUTALLI HYBRID
'EDDIE'S WHITE WONDER'

- NOTES:
- ALL TREE LOCATIONS ARE CONCEPTUAL AND ARE TO BE FIELD VERIFIED BY THE ENGINEER PRIOR TO EXCAVATION OF PLANTING PITS TO ENSURE PROPER PLACEMENT WITH RESPECT TO VIEWS, SIGHT DISTANCES, AND CLEARANCES FROM STREET EDGE AND/OR UTILITIES.
 - PRIOR TO CONSTRUCTION, THE CONTRACTOR SHALL NOTIFY THE ENGINEER TO REQUEST FIELD MARKING OF PLANT MATERIALS TO BE REMOVED (48 HOUR NOTICE). ALL PLANT MATERIALS NOT DESIGNATED TO BE REMOVED SHALL BE RETAINED AND PROTECTED. LIMITS OF GRADING SHALL BE FIELD MARKED BY THE ENGINEER. WHERE GRADING EXTENDS WITHIN THE DRIPLINE OF EXISTING TREES AND SHRUBS TO BE RETAINED, THE CONTRACTOR SHALL REQUEST FIELD DIRECTION TO EITHER TRANSPLANT OR TO ALTER GRADING TO MINIMIZE IMPACTS TO THE PLANT MATERIALS. PLANT MATERIAL DESTROYED AND/OR IRREPARABLY DAMAGED DUE TO LACK OF DIRECTION AND/OR LACK OF PROPER CARE BY THE CONTRACTOR SHALL BE REPLACED IN KIND AND/OR EVALUATED TO ASSESS DAMAGE WITH VALUE DEDUCTED FROM THE CONTRACT.

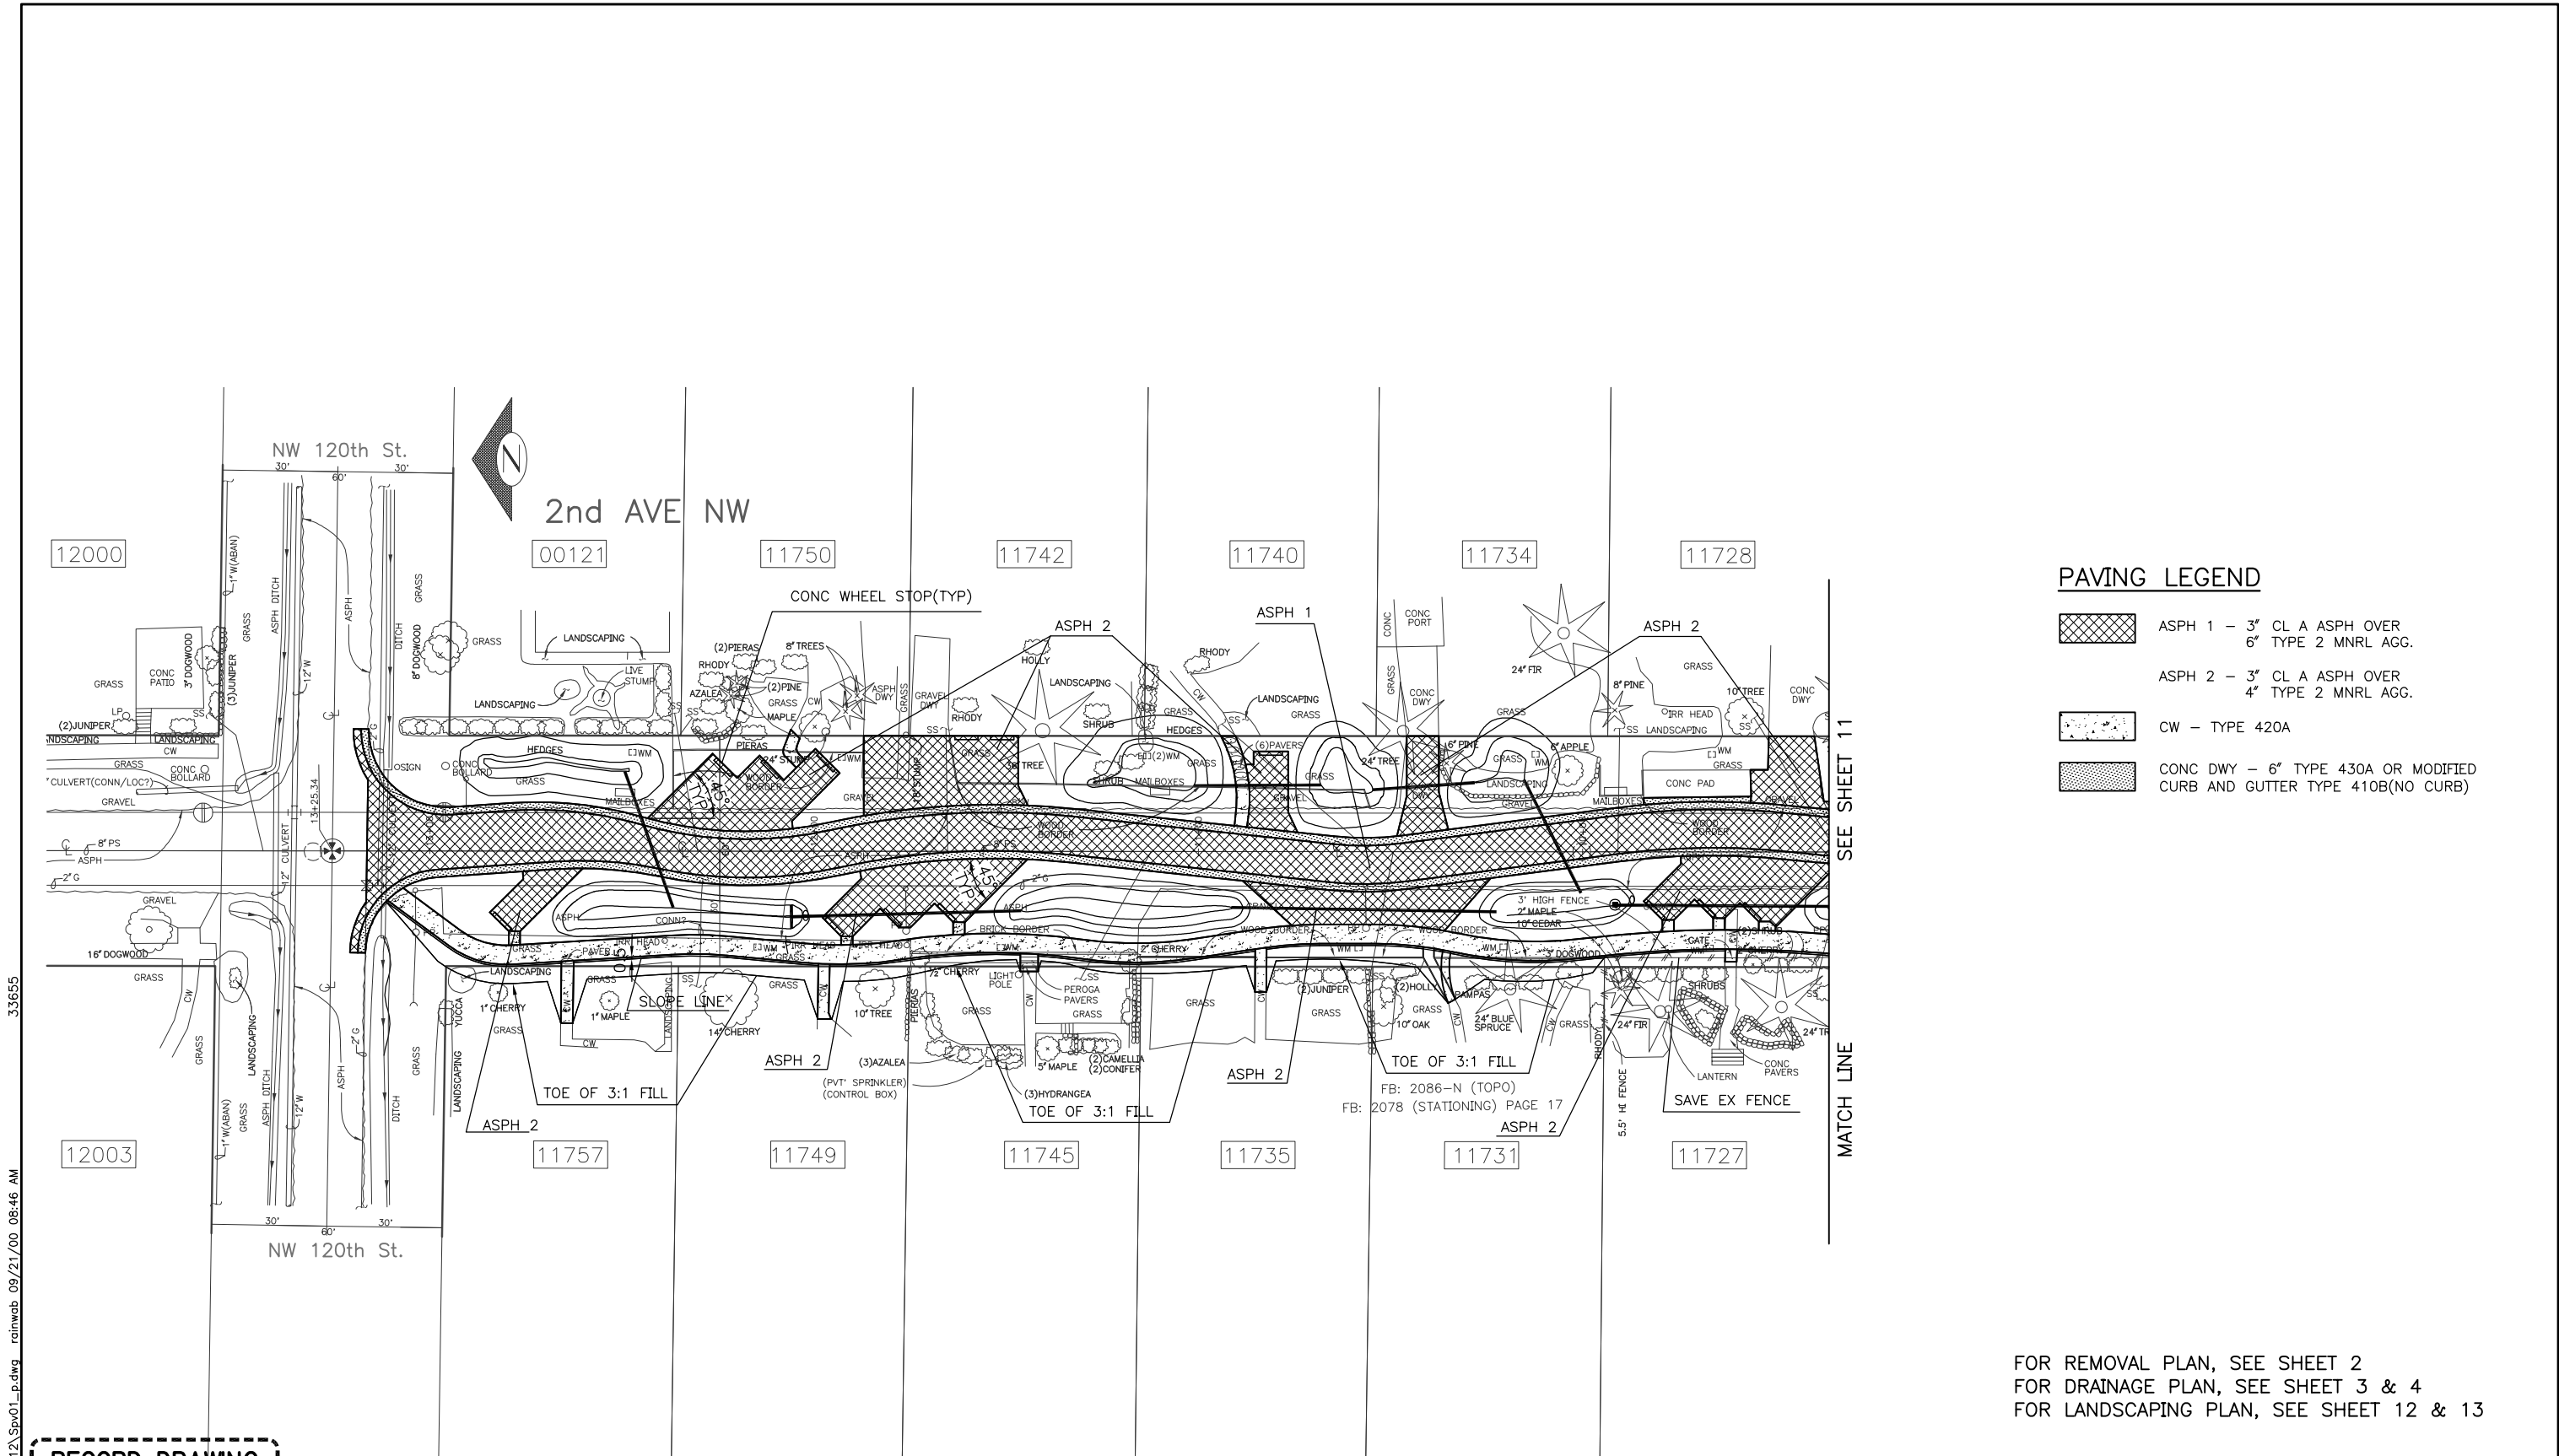

PAVING LEGEND

- ASPH 1 - 3" CL A ASPH OVER 6" TYPE 2 MNRL AGG.
- ASPH 2 - 3" CL A ASPH OVER 4" TYPE 2 MNRL AGG.
- CW - TYPE 420A
- CONC DWY - 6" TYPE 430A OR MODIFIED CURB AND GUTTER TYPE 410B(NO CURB)

FOR REMOVAL PLAN, SEE SHEET 2
FOR DRAINAGE PLAN, SEE SHEET 3 & 4
FOR LANDSCAPING PLAN, SEE SHEET 12 & 13

RECORD DRAWING

PAVING PLAN

APPROVED FOR ADVERTISING DWIGHT DIVELY EXECUTIVE SERVICES DIRECTOR SEATTLE, WASHINGTON 20		NAME OR INITIALS AND DATE DESIGNED CHECKED		INITIALS AND DATE REVIEWED: DES. SPU CONST. SEATRA PROJ. MGR.		City of Seattle SEATRA Seattle Transportation		S.E.A. STREETS 2ND AVENUE NW (NW 117TH TO NW 120TH)		PC C399312 R/W CO C399312 VAULT PLAN NO. 774-162 SHEET 10 OF 14	
BY: CONTRACTING MANAGER		DRAWN CHECKED		RECEIVED REVISED AS BUILT		ORDINANCE NO. APPROVED					
		ALL WORK DONE IN ACCORDANCE WITH THE CITY OF SEATTLE STANDARD PLANS AND SPECIFICATIONS AND OTHER DOCUMENTS CALLED FOR IN SECTION 0-02.3 OF THE PROJECT MANUAL.				FUND: SCALE: H. V. INSPECTOR'S BOOK.					

P:\RecordDrawings\C399312\Sis03_p.dwg rainwb 09/21/00 08:31 AM 33655

TREE SCHEDULE						DECIDUOUS TREES				EVERGREEN TREES				DECIDUOUS SHRUBS						EVERGREEN SHRUBS									
						2-2½" CAL.		1½-1¾" CAL.		5-6' HT.				2 GALLON						2 GALLON									
ADDRESS	⊙ L.F.	⊙ S.F. SEED	⊙ S.F. PLANTED	ORGANIC MULCH C.Y.	BARK MULCH C.Y.	FRAXINUS OXYCARPA 'RAYWOOD'	ACER TRUNCATUM	PACIFIC SUNSET MAPLE	CORNUS HYBRID 'EDDIES WHITE'	AMELANCHIER LAEVIS 'CUMULUS'	CORYLUS CORNUJA HAZELNUT	ACER CIRCINATUM VINE MAPLE	ARBUTUS UNEDO STRAWBERRY TREE	PINUS THUNBERGIANA JAPANESE BLACK PINE	CALOCEDRUS DECURRENS INCENSE CEDAR	CHAMAECYPARIS OBTUSA 'HINOKI CYPRESS'	CHAMAECYPARIS 'PLUMOSA'	VACCINIUM PARVIFLORUM	PHILADELPHUS LEWIS MOCKORANGE	RIBES SANGUINEUM RED CURRANT	ROSA NUTKANA NOOTKA ROSE	CORNUS SERICEA 'FLAVIRAMEA' YELLOW DOGWOOD	CORNUS SERICEA 'FLAVIRAMEA' YELLOW DOGWOOD	RUBUS SPECTABILIS SALMONBERRY	RUBUS PARVIFLORA 'PJM'	RHODODENDRON 'STRANVAESA DAVIDIANA'	ARBUTUS UNEDO 'COMPACTA'	VACCINIUM OVATUM EVERGREEN HUCKLEBERRY	
121 (2ND)	80'	600	700	5	5	-	1	-	-			-	-	-	-	-										6			6
(120TH)	120'	1000	100	3	1	-	3	-	-			-	-	-	-	-													
11750	60'	100	500	3	4	1																				3	3	3	3
11742	60'	200	600	4	5				1	1		1					3		3	3	3	3		6		3	3	3	3
11740	60'	300	1150	5	6		1	2							1		3	1	3	3	3	3		6		3		3	3
11734	60'	300	1100	5	6		1					1					3	1	3	3	3	3		6		3		3	3
11728	60'	200	125	2	1																					6			
11720	60'	140	360	2	2	1																				3	3	3	3
11716	140'	400	1000	5	6	1	1	1	1								6	3	6	6	3			12		6		6	6
124 (2ND)	120'	660	1000	5	6		1	-					-	-		1										6			
(117TH)	80'	1800	500	4	6		3																			6			
11757 (2ND)	120'	450	600	4	4		1	1						-					3		6	6	6			6			6
(120TH)	60'	1200	1200	6	6		1						4													5			
11749	60'	300	460	3	4			2											2		3	3	3						3
11745	60'	200	600	3	4	-	1	1				3	-	-	-	-		2	-	6	-	-	-	-	-	2		3	-
11735	60'	180	320	2	2	-	1	2				-	-	-	1			-	-	-	-	-	-	-	-	3	3	3	-
11731	60'	180	400	3	3	1	1		1			-	-	-	-	-			3		3		3			3	3	3	3
11727	60'	120	400	3	3	-	-	1	-	-	-	2	-	-	-	-		-	3		-	3	3	-	-	3	2	3	2
11723	60'	270	600	4	4			1	2								3			6	6	6	6	6		3		3	3
11715	50'	180	200	2	2				1										3		6	6	6	6	6	3		3	3
11709	60'	480	600	3	4	1	1								1		3		6	6	6	6	6	6		3		6	6
11703 (2ND)	90'	350	660	3	4		1	1	1									-	9	-	9	3				3	2	-	5
(117TH)	120'	1200	1200	6	8	4												-	-	-	-	-	-	-	5	3	-	-	2
ADDITIONAL / FIELD LOCATED PROJECT TOTALS		11,000	15,000	100	100	13	20	16	10	12	12	6	2	4	2	2	6	3	6	12	12	6	12	12	12	12	12	12	12

PLANTING SCHEDULE		DECIDUOUS SHRUBS				GROUND COVER		PERENNIALS/FERNS										GROUND COVER		WETLAND PLANTS																																																																																																																																																																																																																																																																																																																																																																																																																																																																																																																																																																																																																																																																																																																																																																																																																																																																																																																																																																																																																																																																																																																																																																																																							
		1 GALLON				1 GALLON		1 GALLON										4" POTS		6" POTS																																																																																																																																																																																																																																																																																																																																																																																																																																																																																																																																																																																																																																																																																																																																																																																																																																																																																																																																																																																																																																																																																																																																																																																																							
ADDRESS	CORNUS 'KEISEI' DWARF				ROSA RUBRA 'PAVEMENT SERIES' (MIXED VARIETIES)		POTENTILLA FRUTICOSA 'MOONLIGHT'		SYMPHORICARPOS ALBUS SNOWBERRY		GAULTHERIA SHALLOON		MAHONIA REPENS		POLYSTICHUM MUNITUM SWORDFERN		TOLMIEA MENZIESII YOUTH-ON-AGE		IRIS DOUGLASSIANA PACIFIC COAST IRIS		SMILACINA RACEMOSA FALSE SOLOMON'S SEAL		CORNUS CANADENSIS		LUPINE		GERANIUM SANGUINEUM		ASARUM CAUDATUM WILD GINGER		MAINTHEMUM DILATATUM WILD LILY OF THE VALLEY		GEUM MACROPHYLLUM		SIBERIAN IRIS		ARCTOSTAPHYLOS		UVA URSI		FRAGARIA CHLIDENSIS WILD STRAWBERRY		SAGITTARIA LATIFOLIA ARROWHEAD		SCIRPUS MICROCARPUS SMALL-FRUITED BULRUSH		CAREX LENTICULARIS		RANUNCULUS REPENS CREEPING BUTTERCUP		JUNCUS ENSIPOLIUS DAGGERLEAF RUSH		JUNCUS EFFLUSUS SOFT RUSH																																																																																																																																																																																																																																																																																																																																																																																																																																																																																																																																																																																																																																																																																																																																																																																																																																																																																																																																																																																																																																																																																																																																																																						
	121 (2ND) (120TH)	24	16	16		24				6						6									12																																																																																																																																																																																																																																																																																																																																																																																																																																																																																																																																																																																																																																																																																																																																																																																																																																																																																																																																																																																																																																																																																																																																																																																																		

RECORD DRAWING

APPROVED FOR ADVERTISING DWIGHT DIVELY EXECUTIVE SERVICES DIRECTOR SEATTLE, WASHINGTON 20	NAME OR INITIALS AND DATE DESIGNED CHECKED DRAWN CHECKED REVISED AS BUILT	INITIALS AND DATE REVIEWED: SPU CONST. SEATRA PROJ. MGR. RECEIVED REVISED AS BUILT
BY: CONTRACTING MANAGER	ALL WORK DONE IN ACCORDANCE WITH THE CITY OF SEATTLE STANDARD PLANS AND SPECIFICATIONS AND OTHER DOCUMENTS CALLED FOR IN SECTION 0-02.3 OF THE PROJECT MANUAL.	



CITY OF SEATTLE SEATRA Seattle Transportation	ORDINANCE NO. APPROVED FUND: SCALE: H. V. INSPECTOR'S BOOK:
---	--

TREE SCHEDULE AND PLANTING SCHEDULE	
S.E.A. STREETS 2ND AVENUE NW (NW 117TH TO NW 120TH)	
PC R/W CO	C399312 C399312
VAULT PLAN NO. 774-162	
SHEET 14 OF 14	